


T.35S.,R.9E.,W.M.

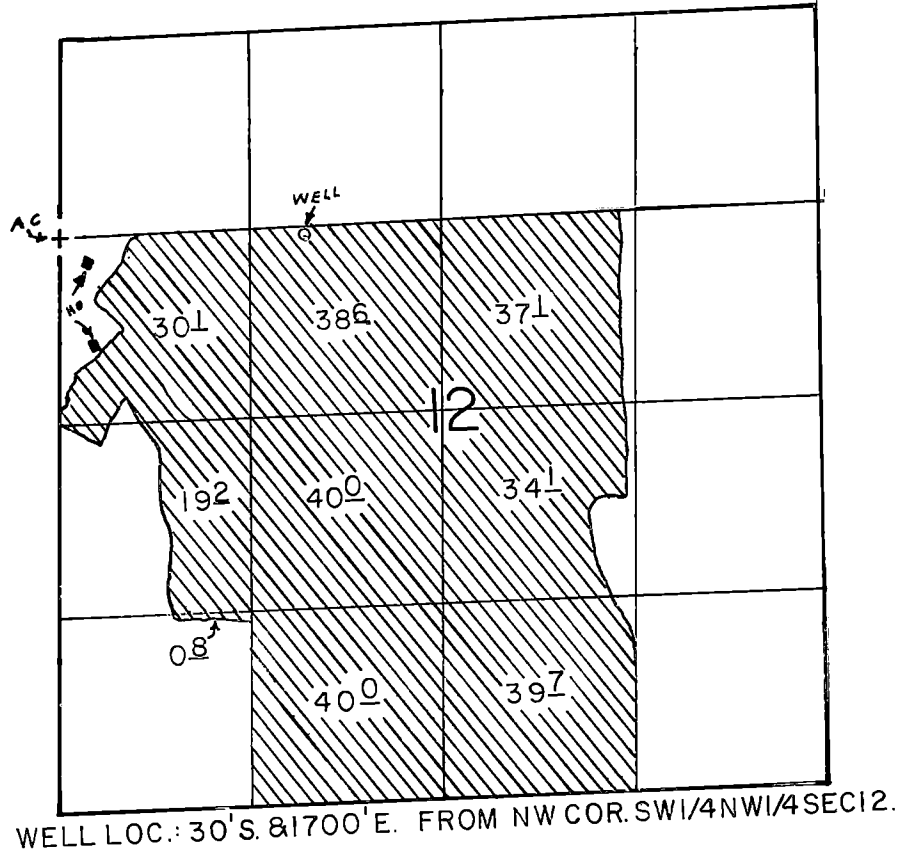

SCALE: 1" = 1320'

FINAL PROOF SURVEY UNDER

Application No. G-5190 Permit No. G-5060.
IN NAME OF

PIEDMONT PROPERTIES

Surveyed JULY 18, 1991, by B.W. BISHOP