

26 25.


35 36

NW NW
Tax Lot 3000
Map 22-31

NE NW
Tax Lot 2900
Map 12-31

Claim of Beneficial Use


Permit No. G-16557
Application No. G-16713

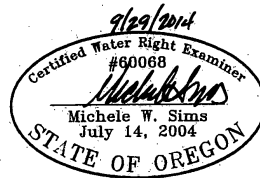

Renewal date: 6/30/2016



Water beneficially used under Permit
G-16557 (priority date 8/22/2006)

 

Buried mainline





Well




Meter



1/16 Section lines

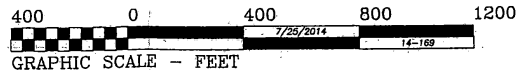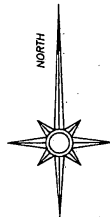

THIS MAP IS FOR THE PURPOSE OF IDENTIFYING THE LOCATION OF THE WATER RIGHT. IT IS NOT INTENDED TO PROVIDE LEGAL DIMENSIONS OR LOCATIONS OF PROPERTY OWNERSHIP LINES.

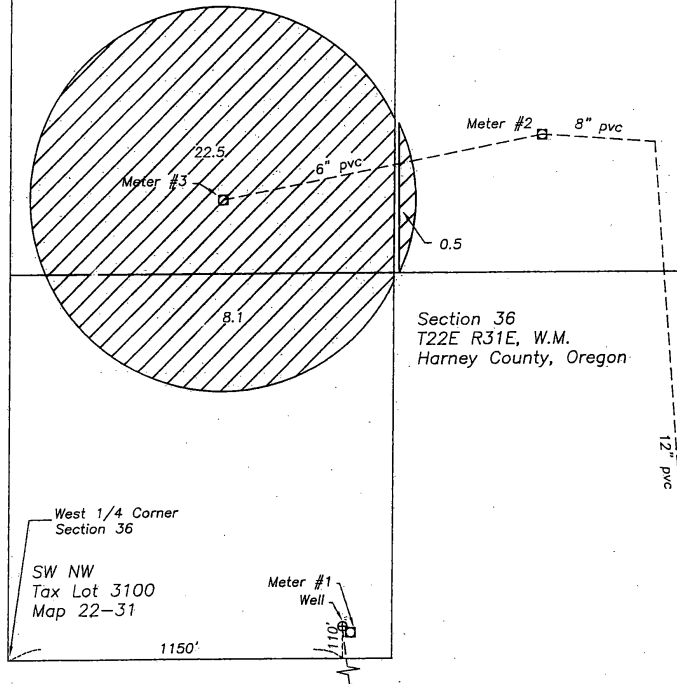

CORU MAP # 860