


T.1S. R.4E. Section 35, W.M.

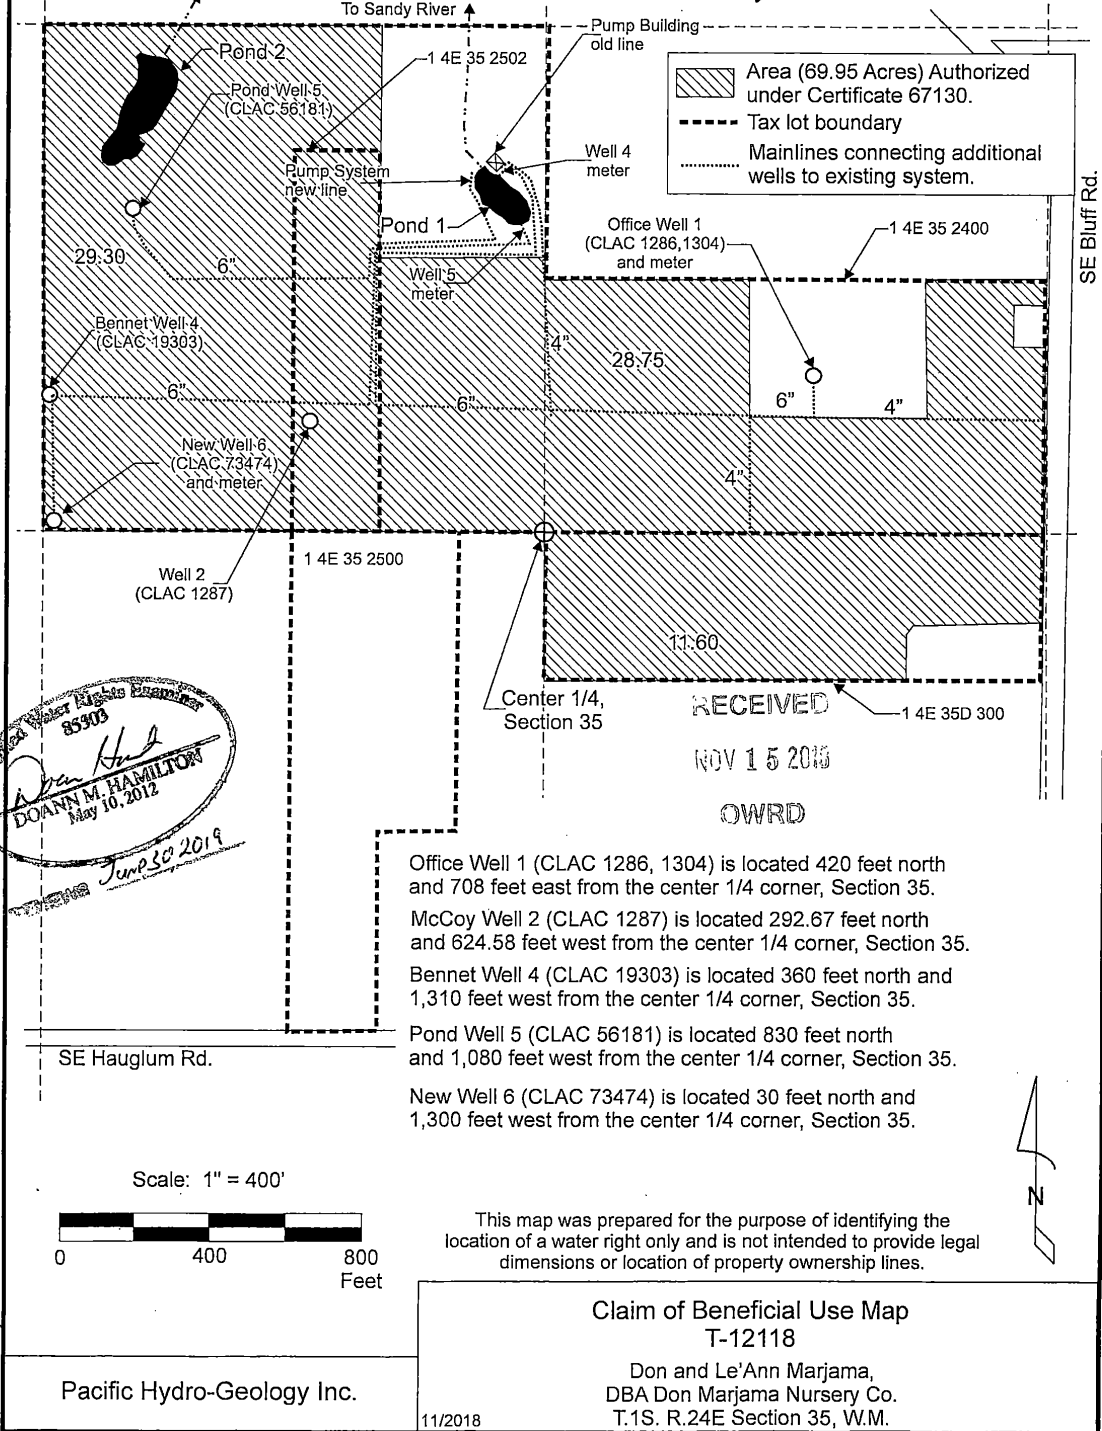

MarjamaT-12118COBU.cdr

Water Rights Examiner
85903
Don Hamilton
DOANN M. HAMILTON
May 10, 2012
JUN 20 2019