


# CLAIM OF BENEFICIAL USE MAP


FOR  
LAKEVIEW WATER USERS  
VICKIE DRINKWATER  
GARY & RAVEILL DENIZ  
DAVID & JODY JONES

SECTIONS 13 AND 24  
TOWNSHIP 39 SOUTH RANGE 19 EAST  
LAKE COUNTY, OREGON

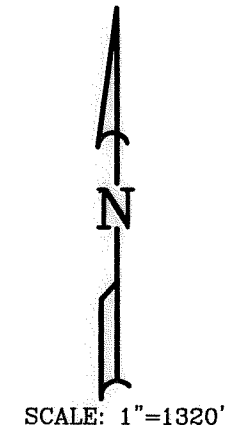

- LEGEND**
- SECTION LINE
  - 1/4 SECTION LINE
  - 1/16 SECTION LINE
  - IRRIGATION MAIN LINE
  - IRRIGATION DITCHES

POINTS OF DIVERSION						
POD NAME	TOWNSHIP	RANGE	MER.	SEC.	Q-Q	COORDINATES
POD 1	38S	19E	WM	29	NW SW	COTTONWOOD CREEK, RESERVOIR: 580 FEET SOUTH AND 900 FEET EAST FROM THE W1/4 CORNER OF SECTION 29
POD 2	39S	19E	WM	16	NE NE	COTTONWOOD CREEK: 860 FEET SOUTH AND 1120 FEET WEST FROM THE NE CORNER OF SECTION 16
POD 3	40S	18E	WM	5	SW SE	DREWS CREEK, RESERVOIR: 120 FEET NORTH AND 1820 FEET WEST FROM THE SE CORNER OF SECTION 5
POD 4	40S	18E	WM	11	SE NW	DREWS CREEK: 1850 FEET SOUTH AND 3400 FEET WEST FROM THE NE CORNER OF SECTION 11
POD 5	38S	19E	WM	29	NW SW	2171 FEET NORTH AND 778 FEET EAST FROM THE SW CORNER OF SECTION 29
POD 6	39S	19E	WM	13	NE SE	NOT LISTED
POD 7	39S	19E	WM	13	SW SE	NOT LISTED

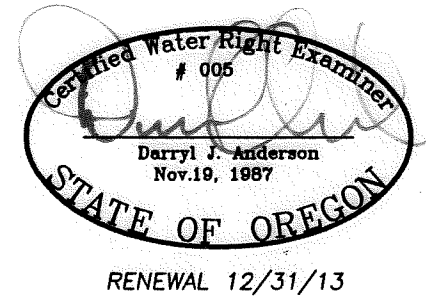

- PLACE OF USE WELL #1
- PLACE OF USE POD 1-4 PRIMARY  
POD 5 SUPPLEMENTAL
- PLACE OF USE POD 6-7
- PLACE OF USE WELL #2

TRANSFER NO. T-9986

NOTE:  
PREPARATION OF THIS MAP IS FOR IDENTIFYING PROPOSED WATER RIGHTS ONLY. IT HAS NO INTENT TO PROVIDE LOCATIONS OR DIMENSIONS OF PROPERTY BOUNDARIES.

REVISION	BY

**ANDERSON ENGINEERING  
AND SURVEYING, INC.**

P.O. BOX 28  
LAKEVIEW, OREGON 97630  
(541) 947-4407  
FAX: 947-2321

FOR:  
VICKIE DRINKWATER  
18974 LAKE RIDGE RD  
LAKEVIEW, OR 97630  
541-947-4683

**CLAIM OF BENEFICIAL USE  
TRANSFER NO. T-9986**

DATE:	5/09/2013
SCALE:	1"=1320'
DWG. BY:	R.C.
JOB:	2013-032
FILE:	2013-032
SHEET:	1 OF 1

COBU MAP #773