C. 19820
T-10293
DIM.

T.1N.R.3W.W.M.

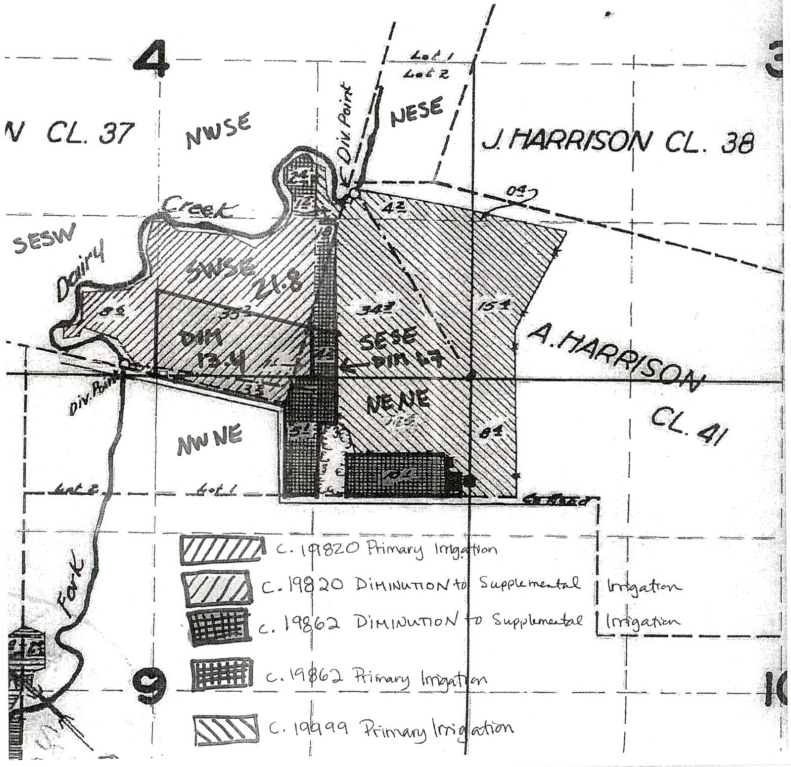

RECEIVED
JAN 11 2019
OWRD