


89649 TL 1000 + 1101
41379

16

Co. Rd.

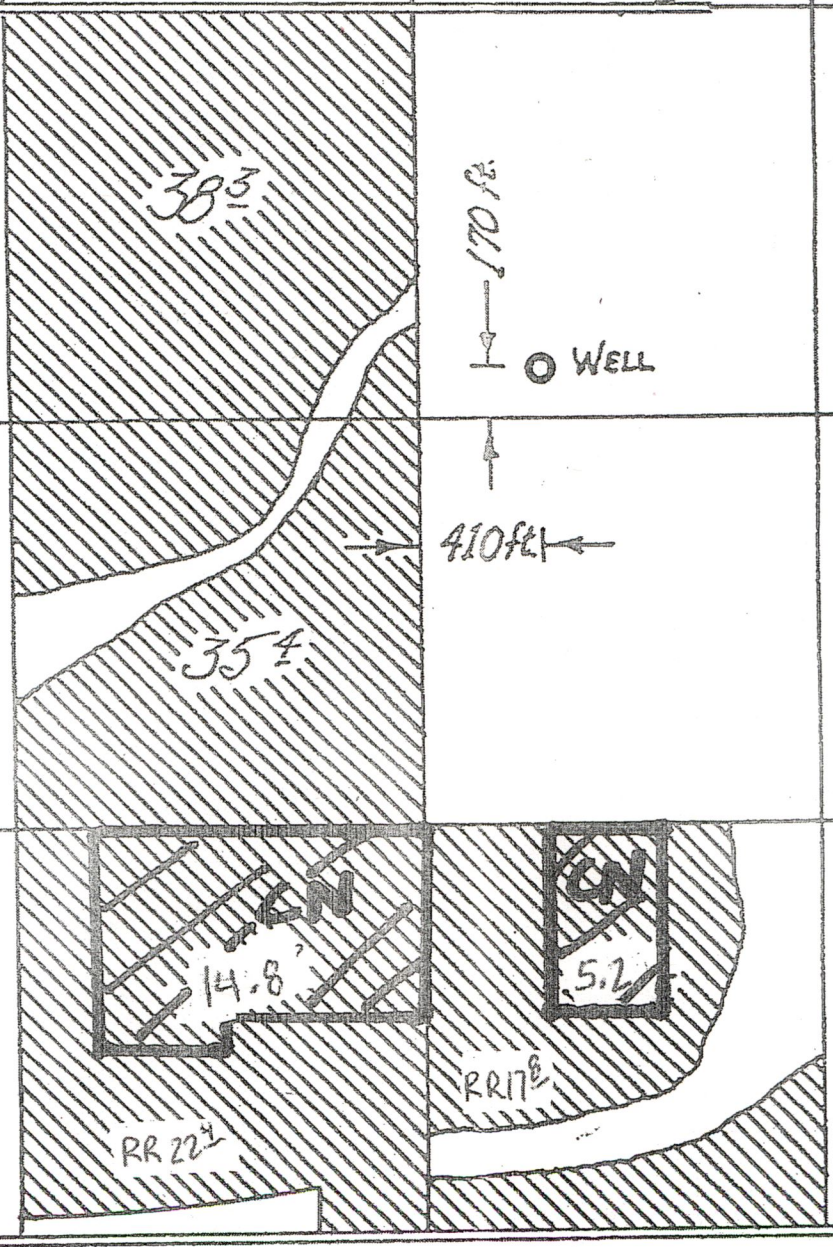

383

170 ft.
WELL

354

410 ft.

CN
14.8

CN
5.2

RR 22'

RR 17'

Co. Rd.

Nursey road

16

RECEIVED

JAN 11 2019

OWRD