


T. 1 S., R. 3 W., W. M.

Section 16
Washington County, Oregon

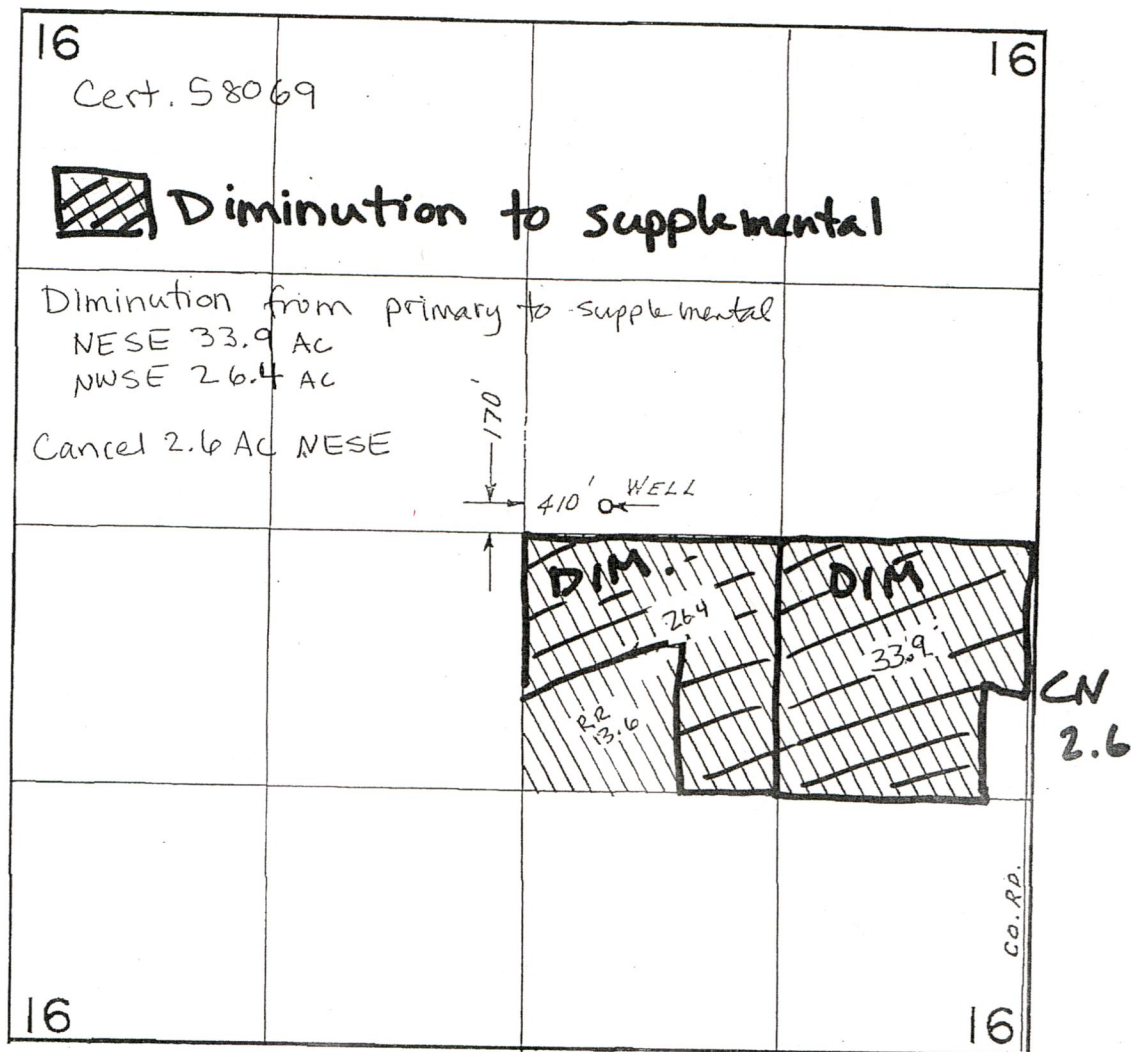

SCALE: 1" = 1320'