


# CW-36, Order 26, Claim of Beneficial Use Map for Places of Use on Bureau of Land Management Medford District Lands

RECEIVED

OCT 1 1 2007



Certified Water Right Examiner  
# 841  
*Gordon R Lyford*  
Gordon R/Lyford  
January 19, 1993  
STATE OF OREGON  
9-15-2007  
Exp 12-31-2008

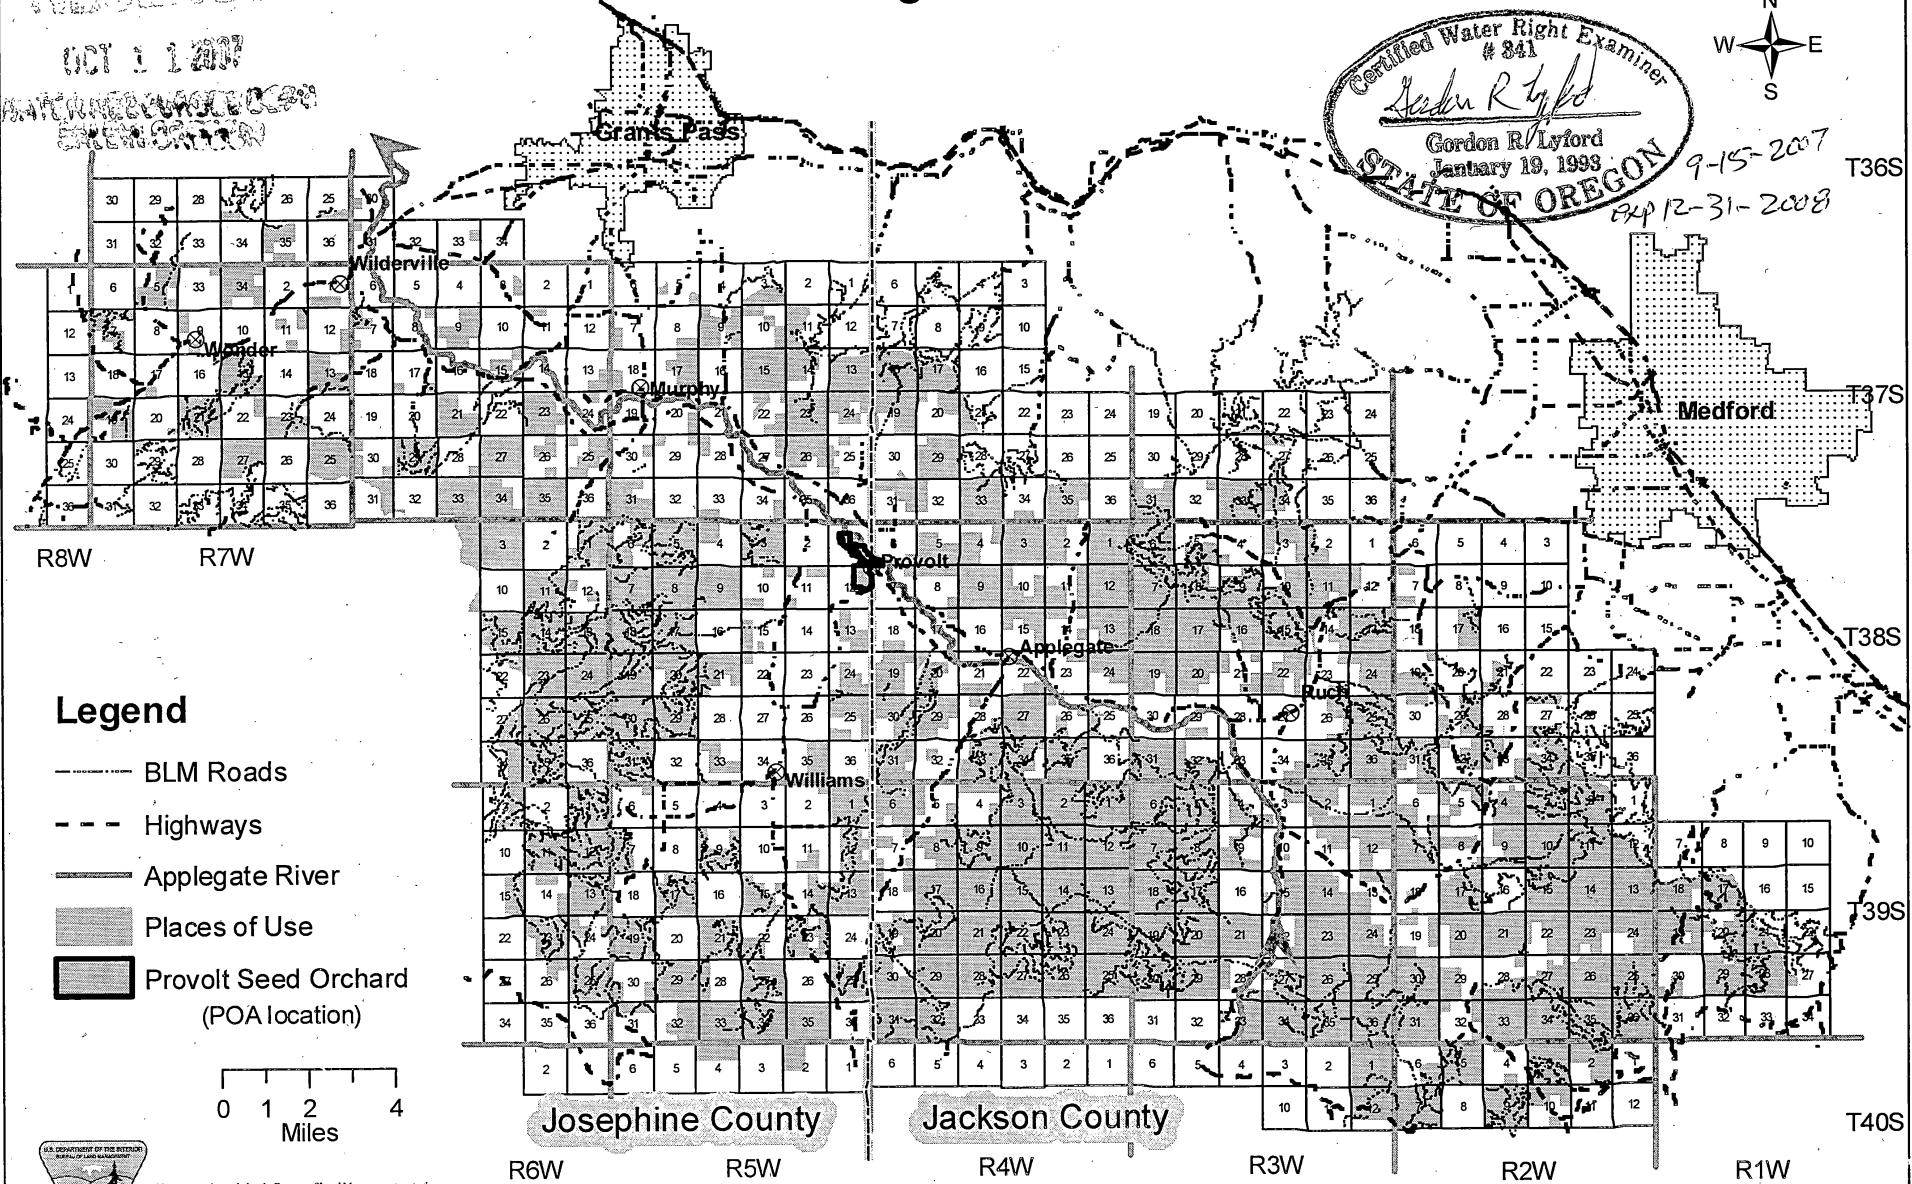

## Legend

- BLM Roads
- Highways
- Applegate River
- Places of Use
- Provolt Seed Orchard  
(POA location)

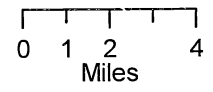

No warranty is made by the Bureau of Land Management as to the accuracy, reliability, or completeness of those data for individual or aggregate use with other data. Original data were compiled from various sources. This information may not meet National Map Accuracy Standards. This product was developed through digital means and may be updated without notification.