



MAP FOR
Transfer Map
S31, T9S, R1W, LINN COUNTY
Certificate 48385

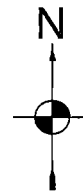

1 IN = 1320 FT
0 660 1320

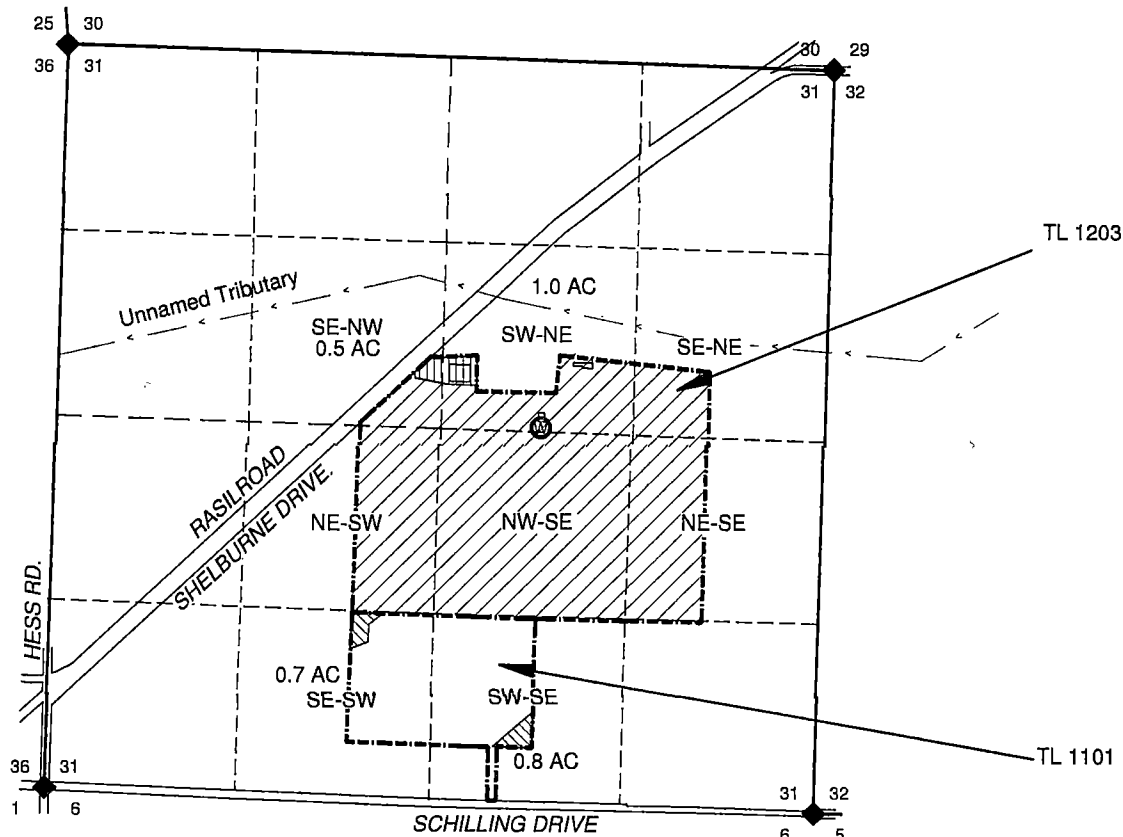


THE WELL IS 50 FEET NORTH AND 1950 FEET WEST OF THE EAST 1/4 OF S31 (PER CERTIFICATE).

NOTES:

- THIS MAP IS NOT INTENDED TO PROVIDE LEGAL DIMENSIONS OR LOCATIONS OF PROPERTY OWNERSHIP LINES.
- PROPERTY LINES AND QUARTER-QUARTER LINES ARE BASED THE TAX ASSESSOR MAP FOR SECTION 31, T9S, R1W.
- NO DONATION LAND CLAIM LINES EXIST NEAR THE PLACE OF USE.
- WATER CONVEYANCE LINES SHALL BE ALL WITHIN THE PROPERTY AND THEREFORE ARE NOT SHOWN.

LEGEND

- SECTION CORNER
- POINT OF DIVERSION (WELL)
- STREAM OR SURFACE DRAINAGE
- TAX LOT LINE
- SECTION LINE
- QUARTER-QUARTER LINE
- "FROM" LAND
- REMAINING LAND
- "TO" LAND

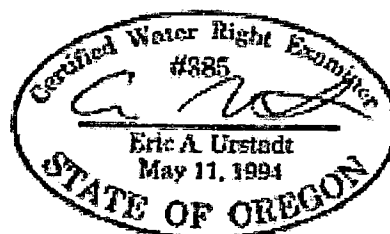


RECEIVED

APR 02 2018

OWRD

MAP BY:
**ASPEN RURAL LAND
CONSULTING**
ERIC URSTADT, PE, PLS
971-250-1520
March 2018
JRSFarms1C

T.9S. R.1W. W.M.

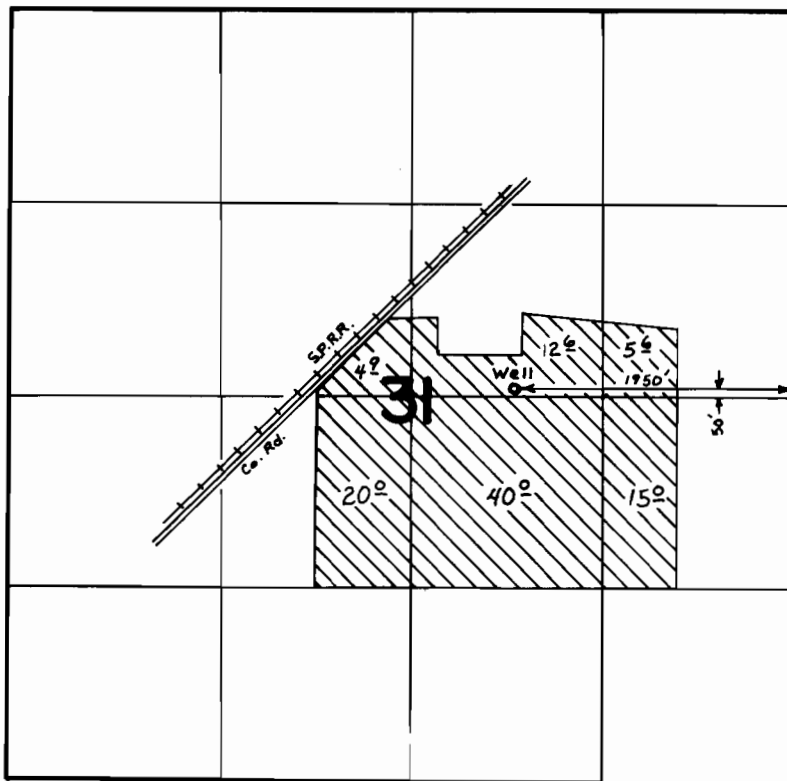

FINAL PROOF SURVEY
UNDER

Application No. G-7213 Permit No. G-6636
IN NAME OF

RICHARD SCHUMACHER

Surveyed AUG. 11, 1977, by D. NORBY