

T6N, R35E, S34 WM
UMATILLA COUNTY



1 in = 400 ft

PRUNEDALE ROAD

1081

COUNTY ROAD

10.75


0.65

WWVRY & OWRR

33 34

04 03

STEPHENS ROAD

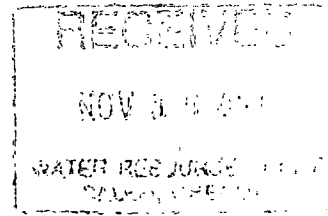

POA is basalt groundwater well located in the NW/4, SW/4, Section 34, T6N, R35E, WM, 776 feet South and 20 feet East from the W 1/4 Corner of Section 34. Flow Meter is located at same location.




PLACE OF USE is 11.4 acres, including:
10.75 acres in NW/4, SW4, Section 34
0.65 acres in SW/4, SW/4, Section 34

--- WATER CONVEYANCE

Water is conveyed from POA to Place of Use via buried 4-inch PVC mainline. Water is applied to orchard with Nelson R2000 Rotators with K3-15deg rotor plates and #11 (orange) nozzles.

The purpose of this map is to identify the location of a water right. It is not intended to provide information regarding the location of property ownership boundary lines.

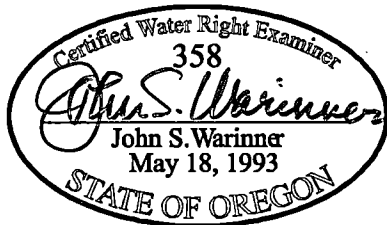

FOUNTAINHEAD
1860 Blue Creek Road
Walla Walla, WA 99362
Phone: 509.529.2646
Fax: 509.522.5251

FINAL PROOF SURVEY MAP
Application G-14340 - Permit G-13247

in the name of
Berle Rothrock
52656 County Road
Milton-Freewater, OR 97862

Revised by John Warinner 10 NOV 2006