




CORR MAP # 1177

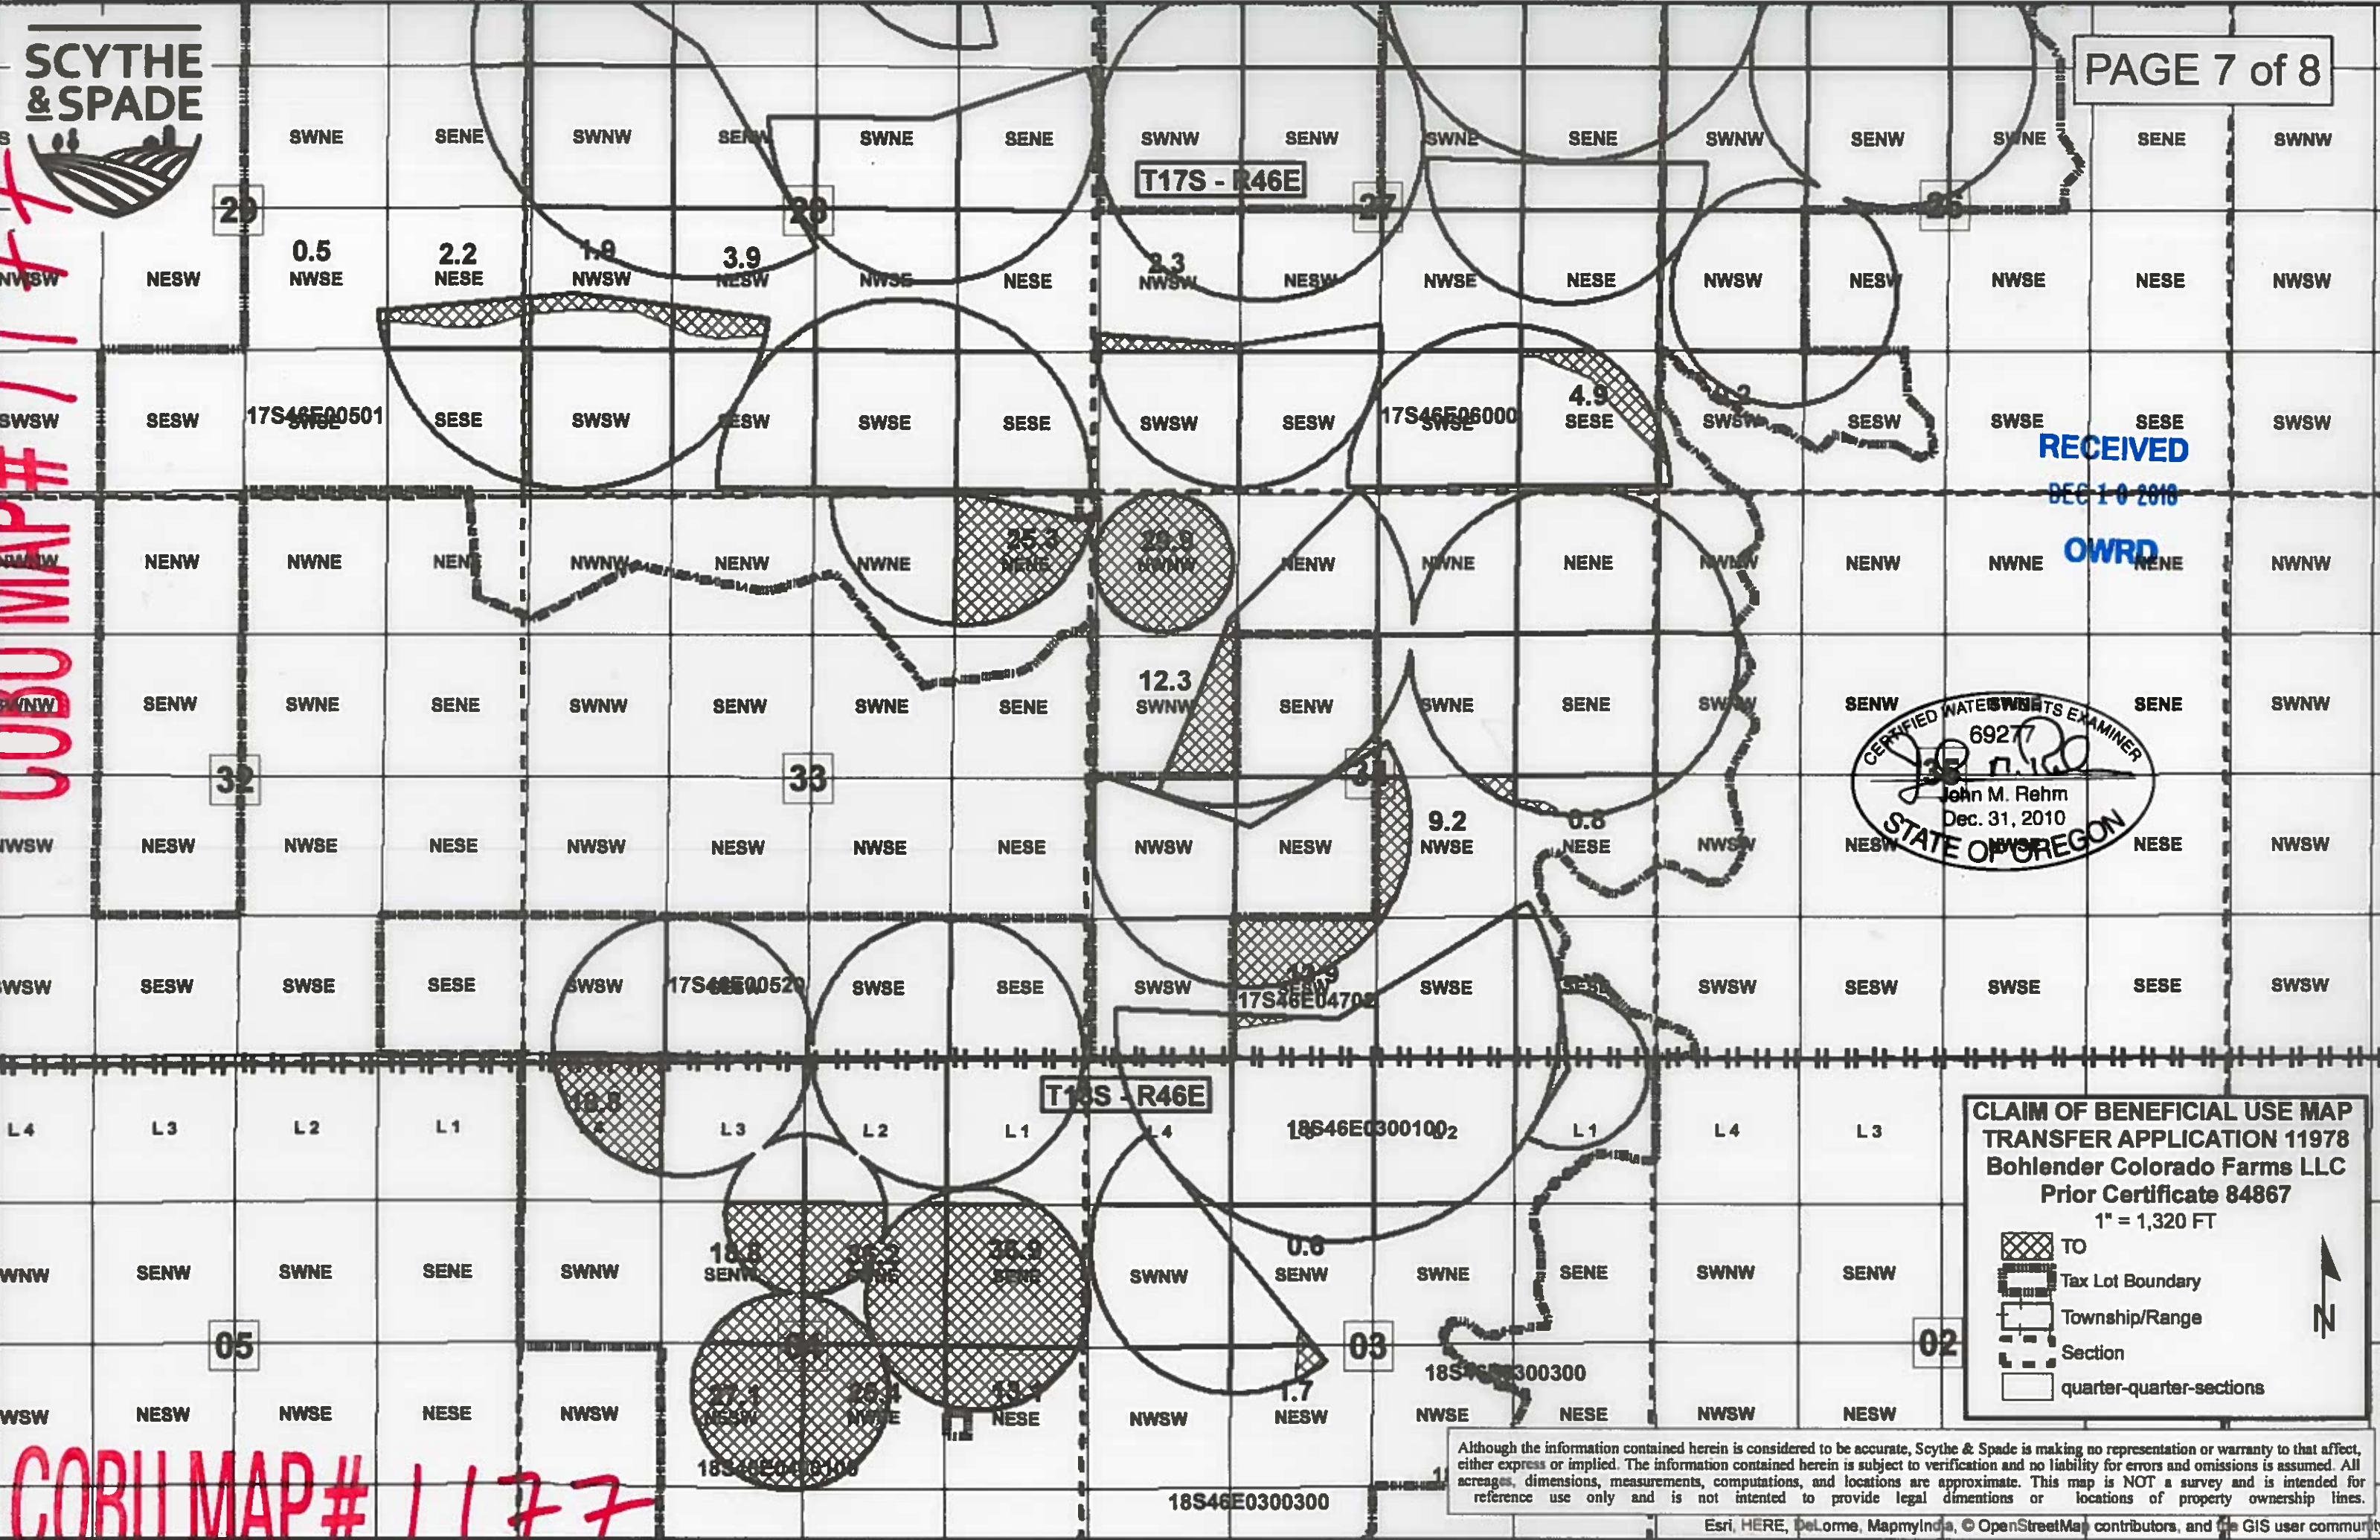

RECEIVED  
OWRD


CERTIFIED WATER RIGHTS EXAMINER  
69277  
John M. Rehm  
Dec. 31, 2010  
STATE OF OREGON

**CLAIM OF BENEFICIAL USE MAP  
TRANSFER APPLICATION 11978  
Bohlender Colorado Farms LLC  
Prior Certificate 84867**  
1" = 1,320 FT

- TO
- Tax Lot Boundary
- Township/Range
- Section
- quarter-quarter-sections

Although the information contained herein is considered to be accurate, Scythe & Spade is making no representation or warranty to that effect, either express or implied. The information contained herein is subject to verification and no liability for errors and omissions is assumed. All acreages, dimensions, measurements, computations, and locations are approximate. This map is NOT a survey and is intended for reference use only and is not intended to provide legal dimensions or locations of property ownership lines.

CORR MAP # 1177

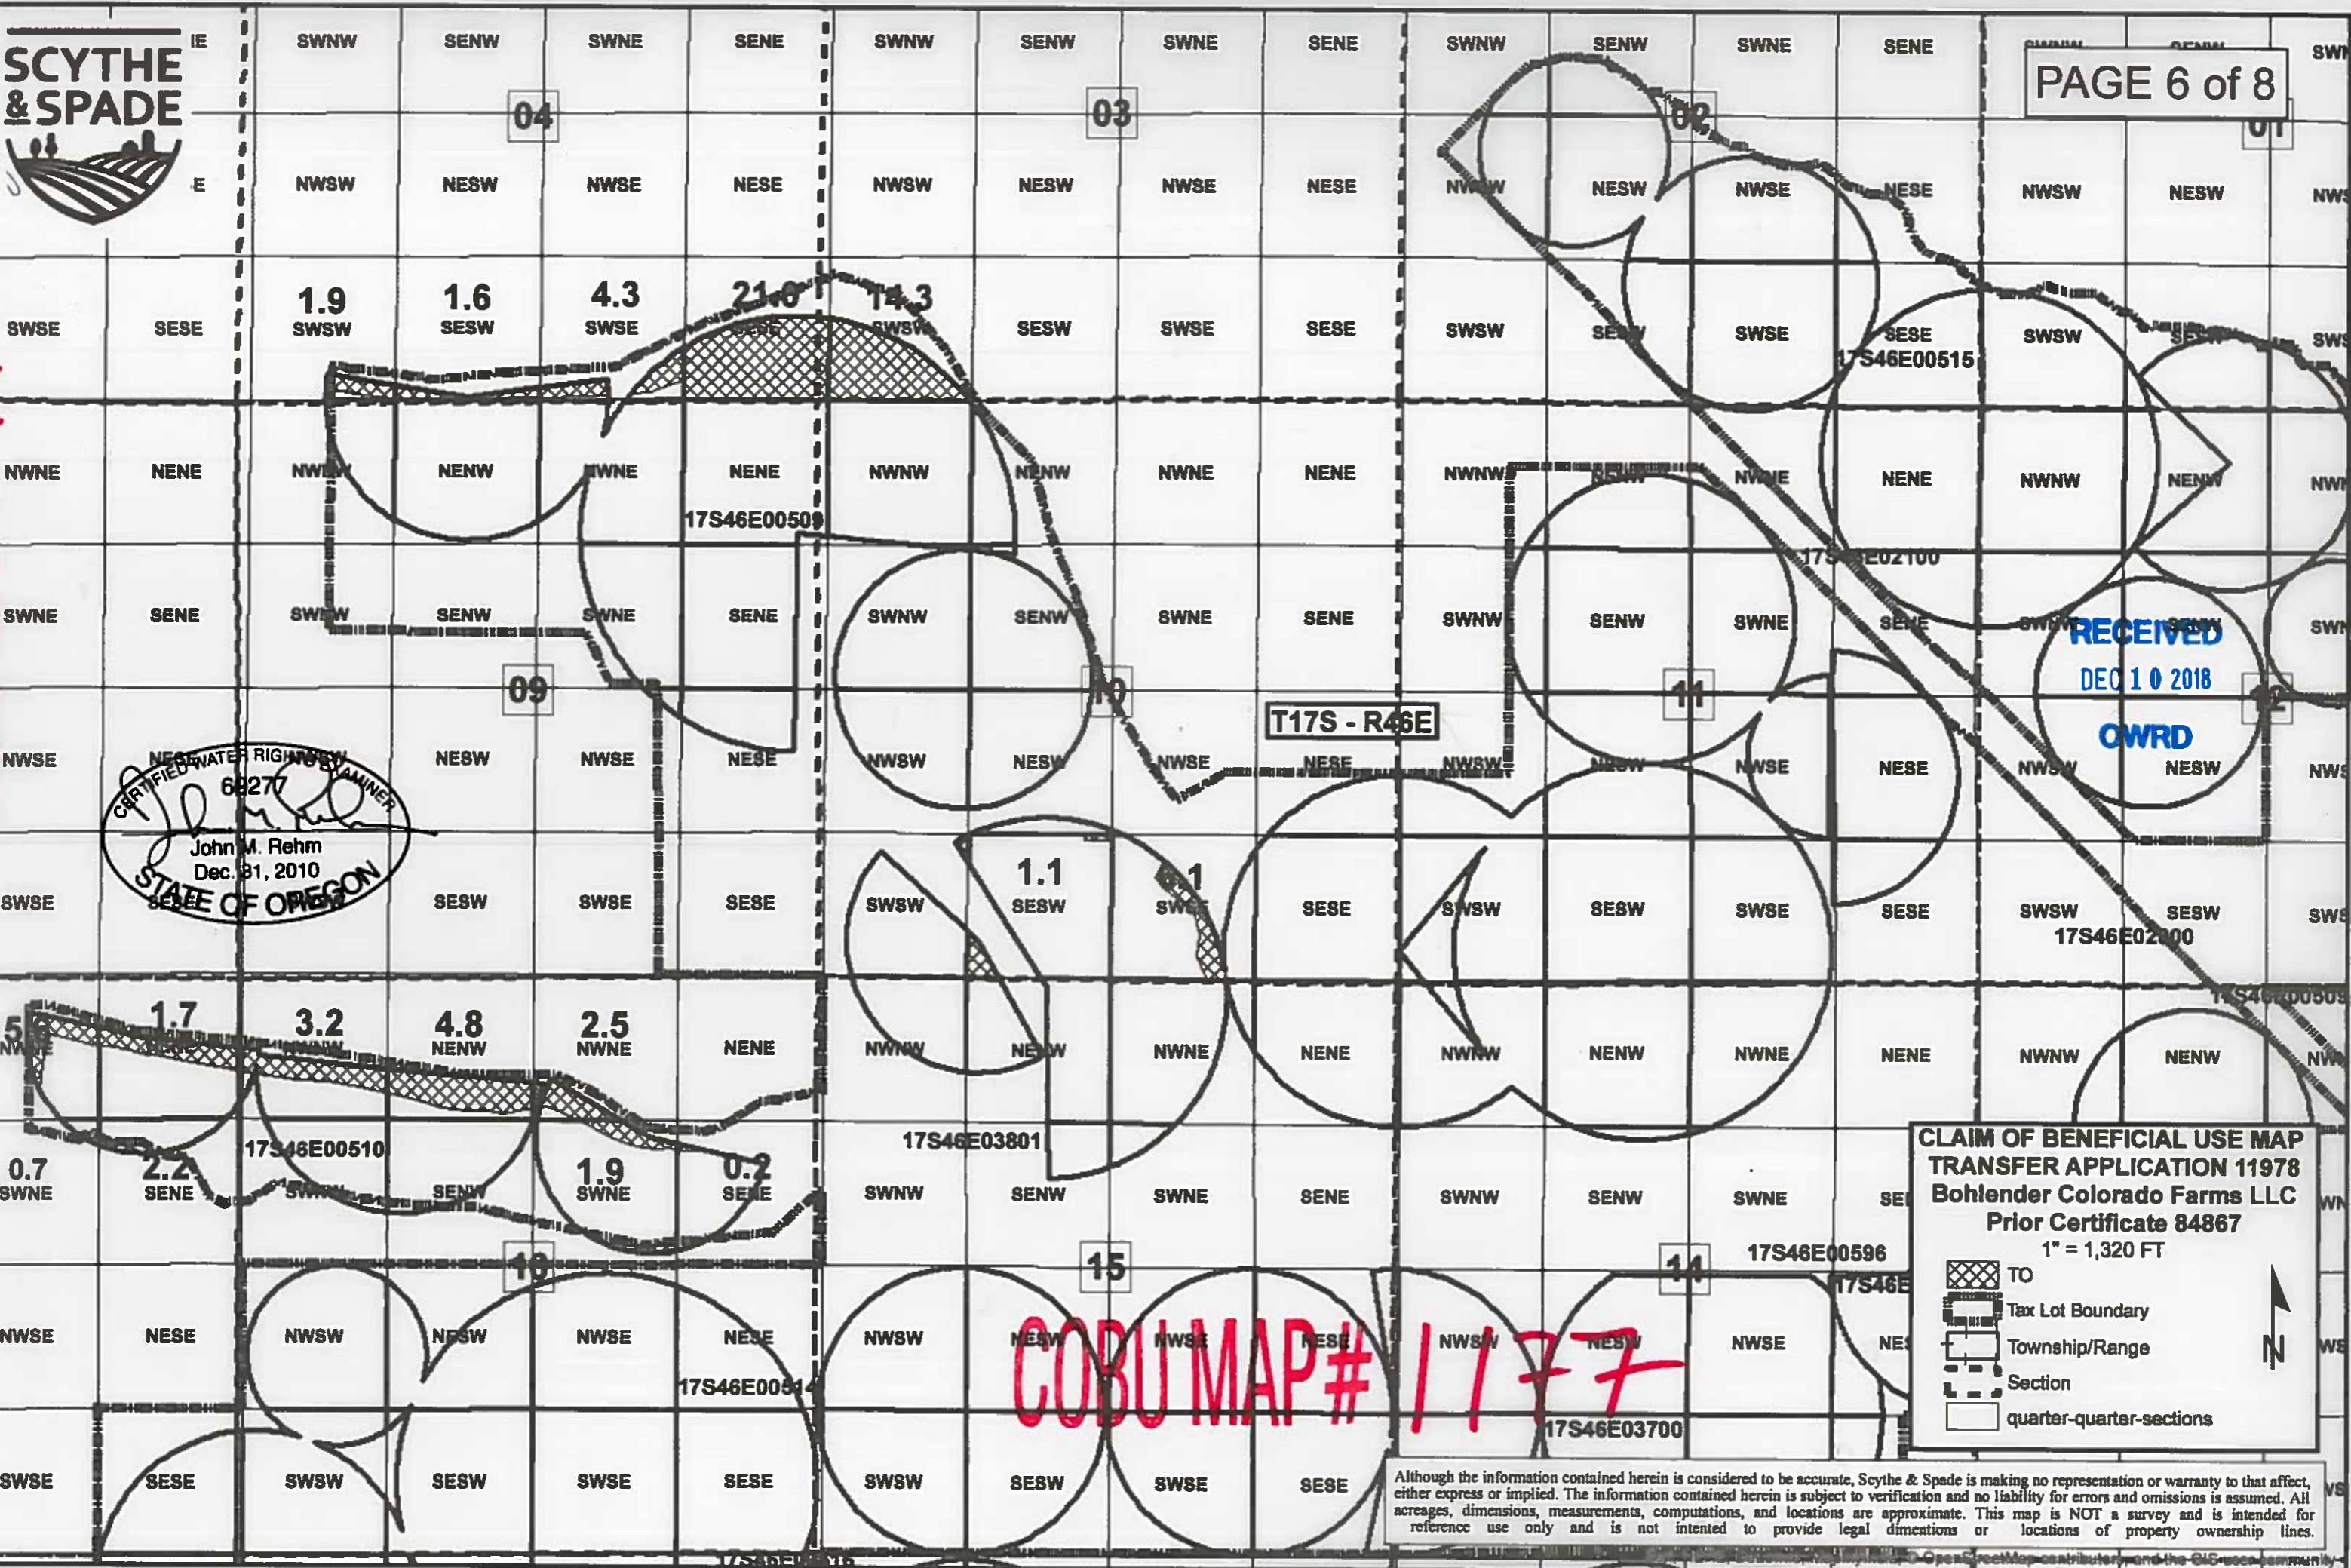

 John M. Rehm  
 Dec. 31, 2010  
 STATE OF OREGON

**CLAIM OF BENEFICIAL USE MAP  
 TRANSFER APPLICATION 11978  
 Bohlender Colorado Farms LLC  
 Prior Certificate 84867**  
 1" = 1,320 FT

TO  
 Tax Lot Boundary  
 Township/Range  
 Section  
 quarter-quarter-sections

Although the information contained herein is considered to be accurate, Scythe & Spade is making no representation or warranty to that affect, either express or implied. The information contained herein is subject to verification and no liability for errors and omissions is assumed. All acreages, dimensions, measurements, computations, and locations are approximate. This map is NOT a survey and is intended for reference use only and is not intended to provide legal dimensions or locations of property ownership lines.

**COBU MAP # 1177**