








1 inch = 1,320 feet

### Claim of Beneficial Use Map

Tracey Lyon  
Application G-15541  
Permit G-17847

#### Legend


-  Area irrigated 326.98 ac
-  Wells
-  Pump Station
-  Pipelines
-  KID D-12 lateral

#### POA information


Well 1 is 355 ft South and  
100 ft East from the W1/4 Cor Sec 11  
Well 2 is 175 ft South and  
2660 ft East from W1/4 Cor Sec 11

#### Tax Lot information

4111-11-TL 400 & 500  
4111-12-TL 600, 800, 900,  
1000 & 1101

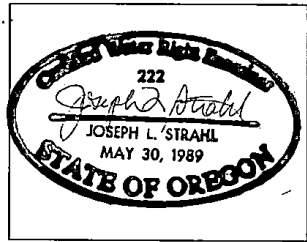

Note: This map is not intended to provide legal dimensions or locations of property ownership lines.

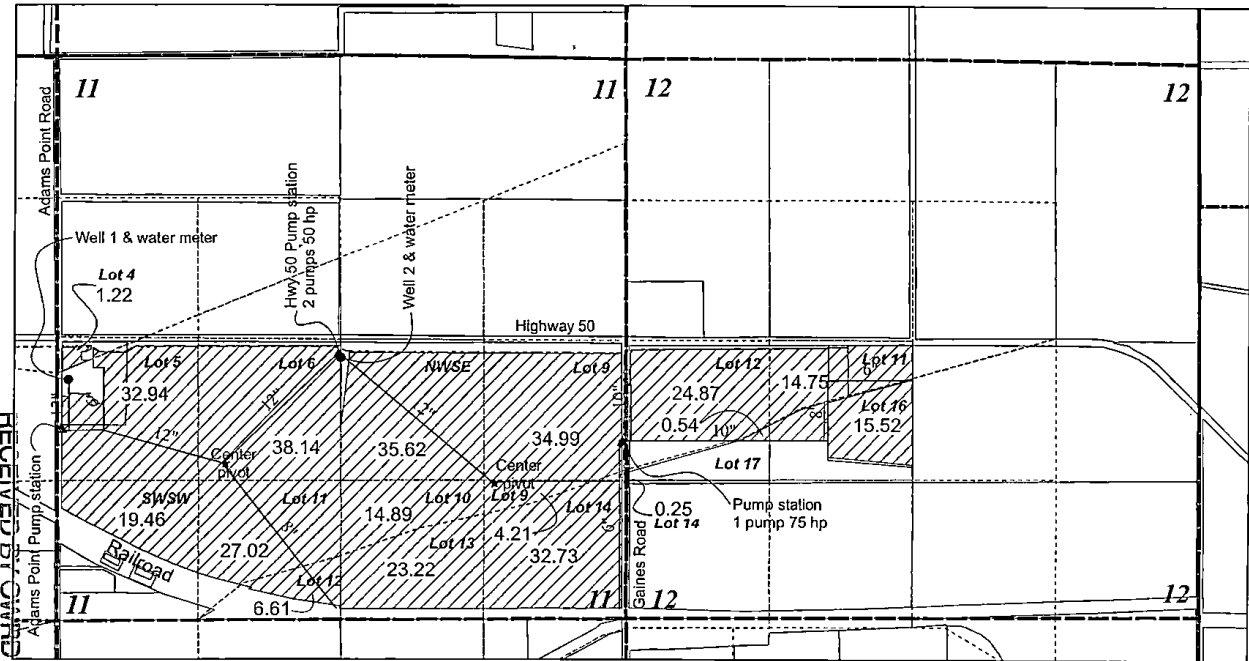

NOV 22 2017  
SALEM, OR

