




# T23S R26E, WM


HARNEY COUNTY, OREGON



0 1,320 Feet


1" = 1,320'

 - Well & Meter
- Pipeline
-  POU IR
-  Section
- Quarter Quarter
-  Tax Lot

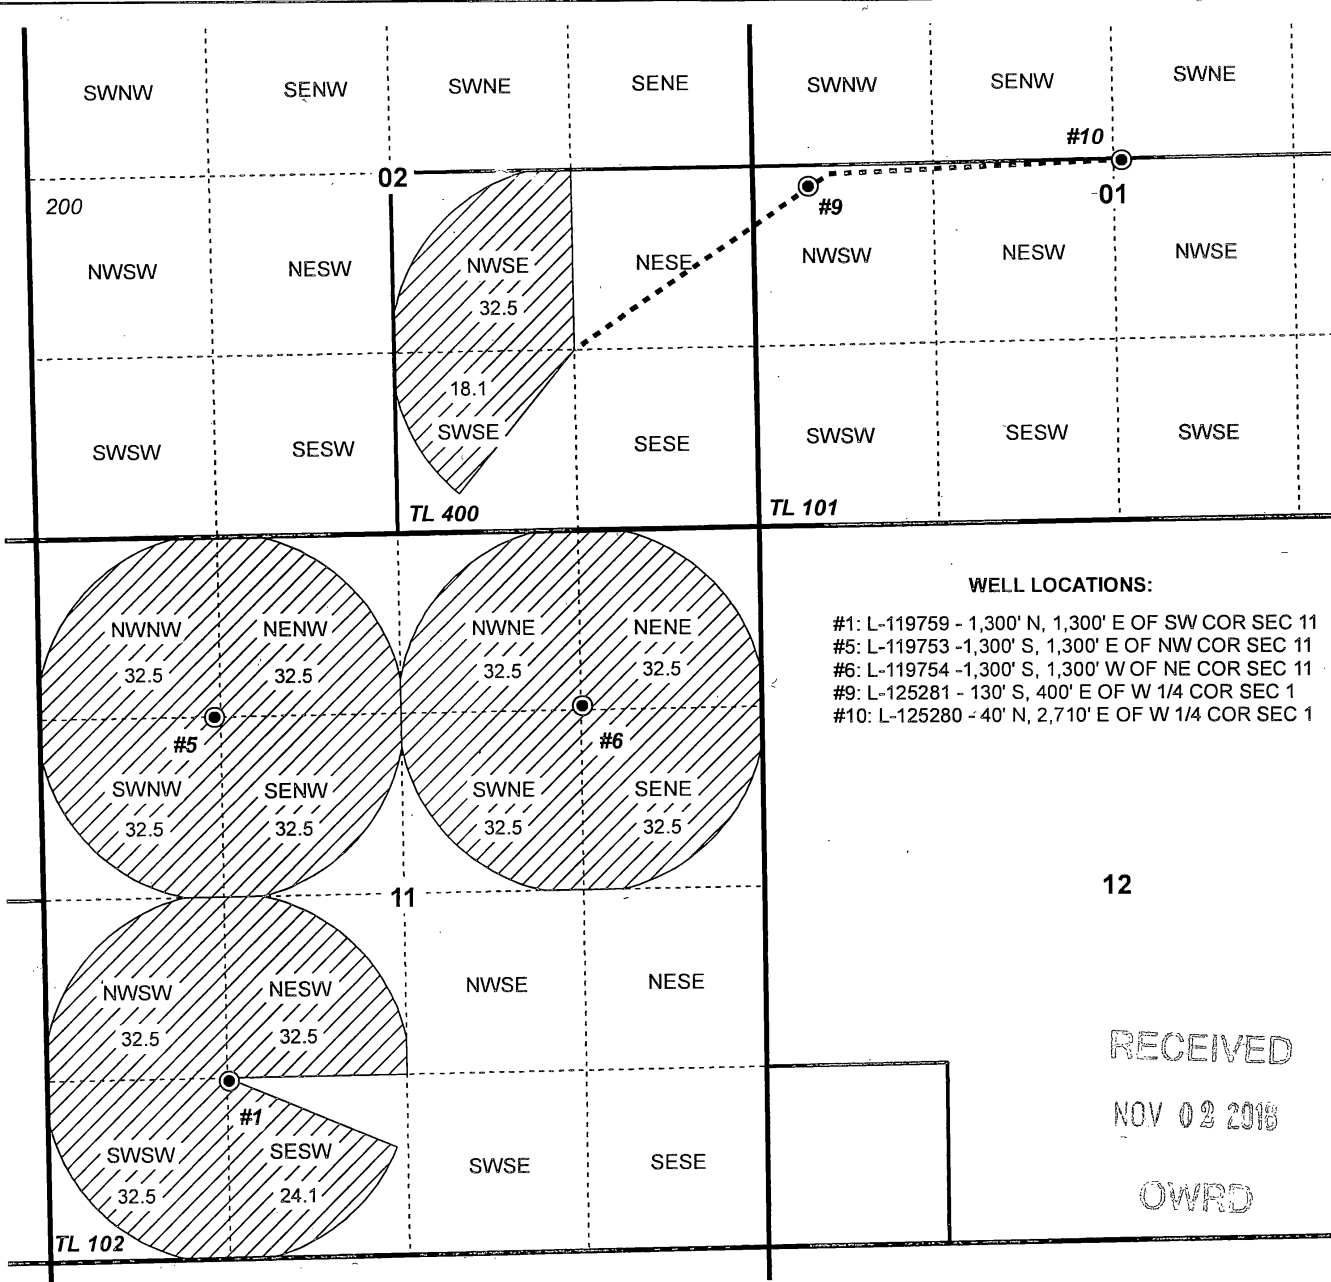

**WELL LOCATIONS:**

- #1: L-119759 - 1,300' N, 1,300' E OF SW COR SEC 11
- #5: L-119753 - 1,300' S, 1,300' E OF NW COR SEC 11
- #6: L-119754 - 1,300' S, 1,300' W OF NE COR SEC 11
- #9: L-125281 - 130' S, 400' E OF W 1/4 COR SEC 1
- #10: L-125280 - 40' N, 2,710' E OF W 1/4 COR SEC 1

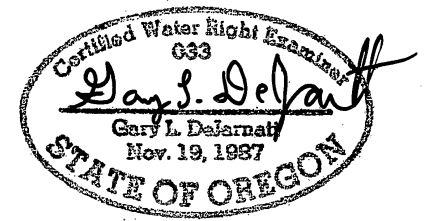

12

RECEIVED


OWRD

RENEWAL DATE 12/31/2019



**CLAIM OF BENEFICIAL USE MAP**  
**Singhose Land & Cattle Company, LLC**  
 T-12376

This map is not intended to provide legal dimensions or locations of property ownership lines.  
 PROJECT #18040  
 Date: 9/26/2018

**WATER RIGHT SERVICES, LLC**  
 PO BOX 1830, BEND, OR 97709  
 WWW.OREGONWATER.US CCB # 197121  
 johnshort@usa.com 541-389-2837