

T. 30 S., R. 5 W., W.M.

SCALE: 1" = 400'

RECEIVED

OCT 29 2018


OWRD

THE PURPOSE OF THIS MAP IS TO IDENTIFY THE LOCATION OF THE WATER RIGHT. IT IS NOT INTENDED TO PROVIDE INFORMATION RELATIVE TO THE LOCATION OF PROPERTY OWNERSHIP BOUNDARY LINES.

OWRD

OCT 29 2018

RECEIVED

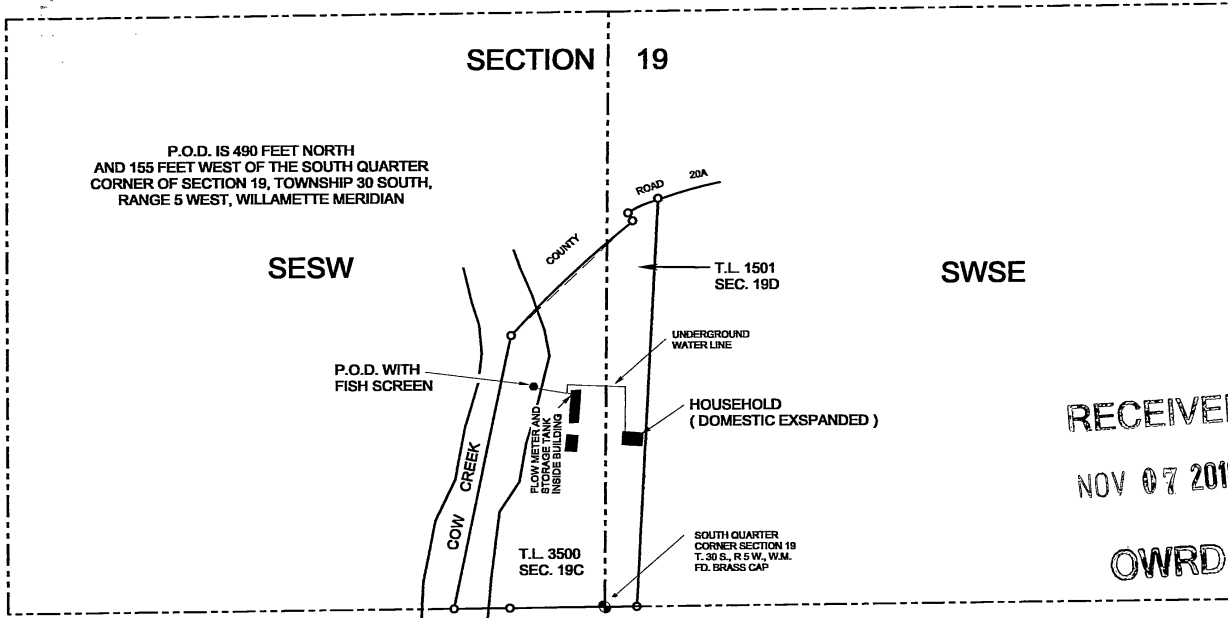

RECEIVED

NOV 07 2018

OWRD

RECEIVED

NOV 07 2018

OWRD

FINAL PROOF SURVEY UNDER

Application No. S-88573


Permit No. S-55146

IN NAME OF

LEE and PENNI ZEIGLER

Surveyed OCT. 16, 2018

by R.F. BROWN

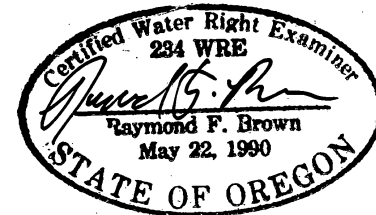

RENEWS: 12/31/2019

LEGEND

- COMPUTED PROPERTY CORNERS
- P. O. D.
- ⊙ GOVERNMENT CORNER
- 40 LINES