

CERTIFICATE 86866

T38S, R10E, Sec.'s 11, 12, 13, 14, & 24, W.M.







KLAMATH COUNTY, OREGON


APPLICATION No. U-319

PERMIT No. U-343

NOTES:

1. THE PURPOSE OF THIS MAP IS TO IDENTIFY THE LOCATION OF THE WATER RIGHT ONLY, AND IS NOT INTENDED TO PROVIDE DIMENSIONS OR LOCATION OF PROPERTY LINES.
2. FOR TAX LOT INFORMATION, SEE TAX MAPS INCLUDED WITH THIS APPLICATION.
3. DATE OF PRIORITY FOR THIS APPLICATION IS JULY 19, 1949.

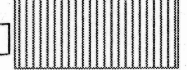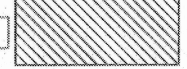
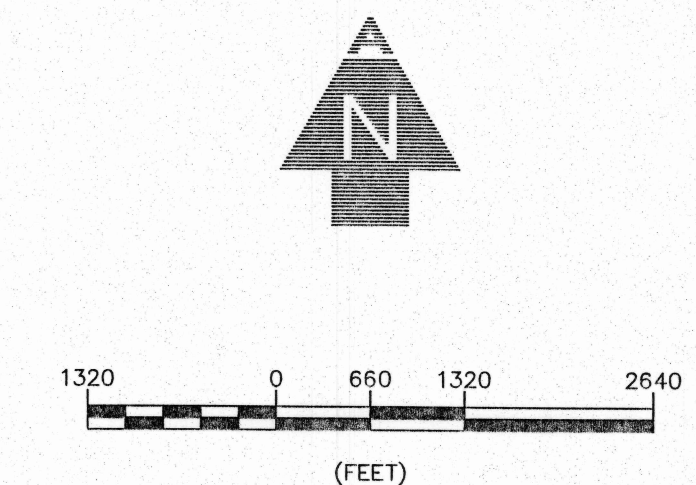


WELL TIES:

- MITCHELL WELL—780' NORTH & 6' EAST FROM THE SOUTHEAST CORNER OF SECTION 24.
- DEER RIDGE WELL—2,840' NORTH & 80' EAST FROM THE SOUTHWEST CORNER OF SECTION 24.
- SWAN LAKE JUNCTION WELL—3,225' NORTH & 1,260' WEST FROM THE SOUTHEAST CORNER SECTION 23.
- LISKEY WELL—800' SOUTH & 430' EAST FROM THE NORTHWEST CORNER SECTION 13.

LEGEND

14 13	SECTION DESIGNATION	10"	MAIN LINE SIZE
23 24	TAX LOT NUMBER	—	SECTION LINES
LOT 1	GOVERNMENT LOT NUMBER	- - - - -	1/4 1/4 LINES
—	PROPERTY BOUNDARY	==	ROADS
30	SECTION CENTER	- - - - -	DITCH LINE
		●	EXISTING P.O.A. (WELL)

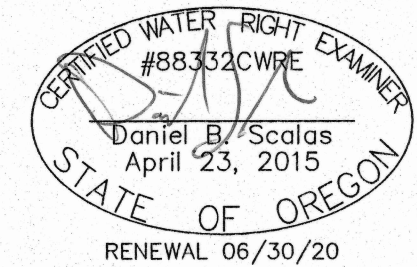


AL ADKINS ENGINEERING & SURVEYING o / 541.884.4666 w / AdkinsEngineering.com

1435 ESPLANADE AVENUE, KLAMATH FALLS, OR 97601

SERVING S. OREGON & N. CALIFORNIA

ENGINEERING • SURVEYING • PLANNING • TESTING

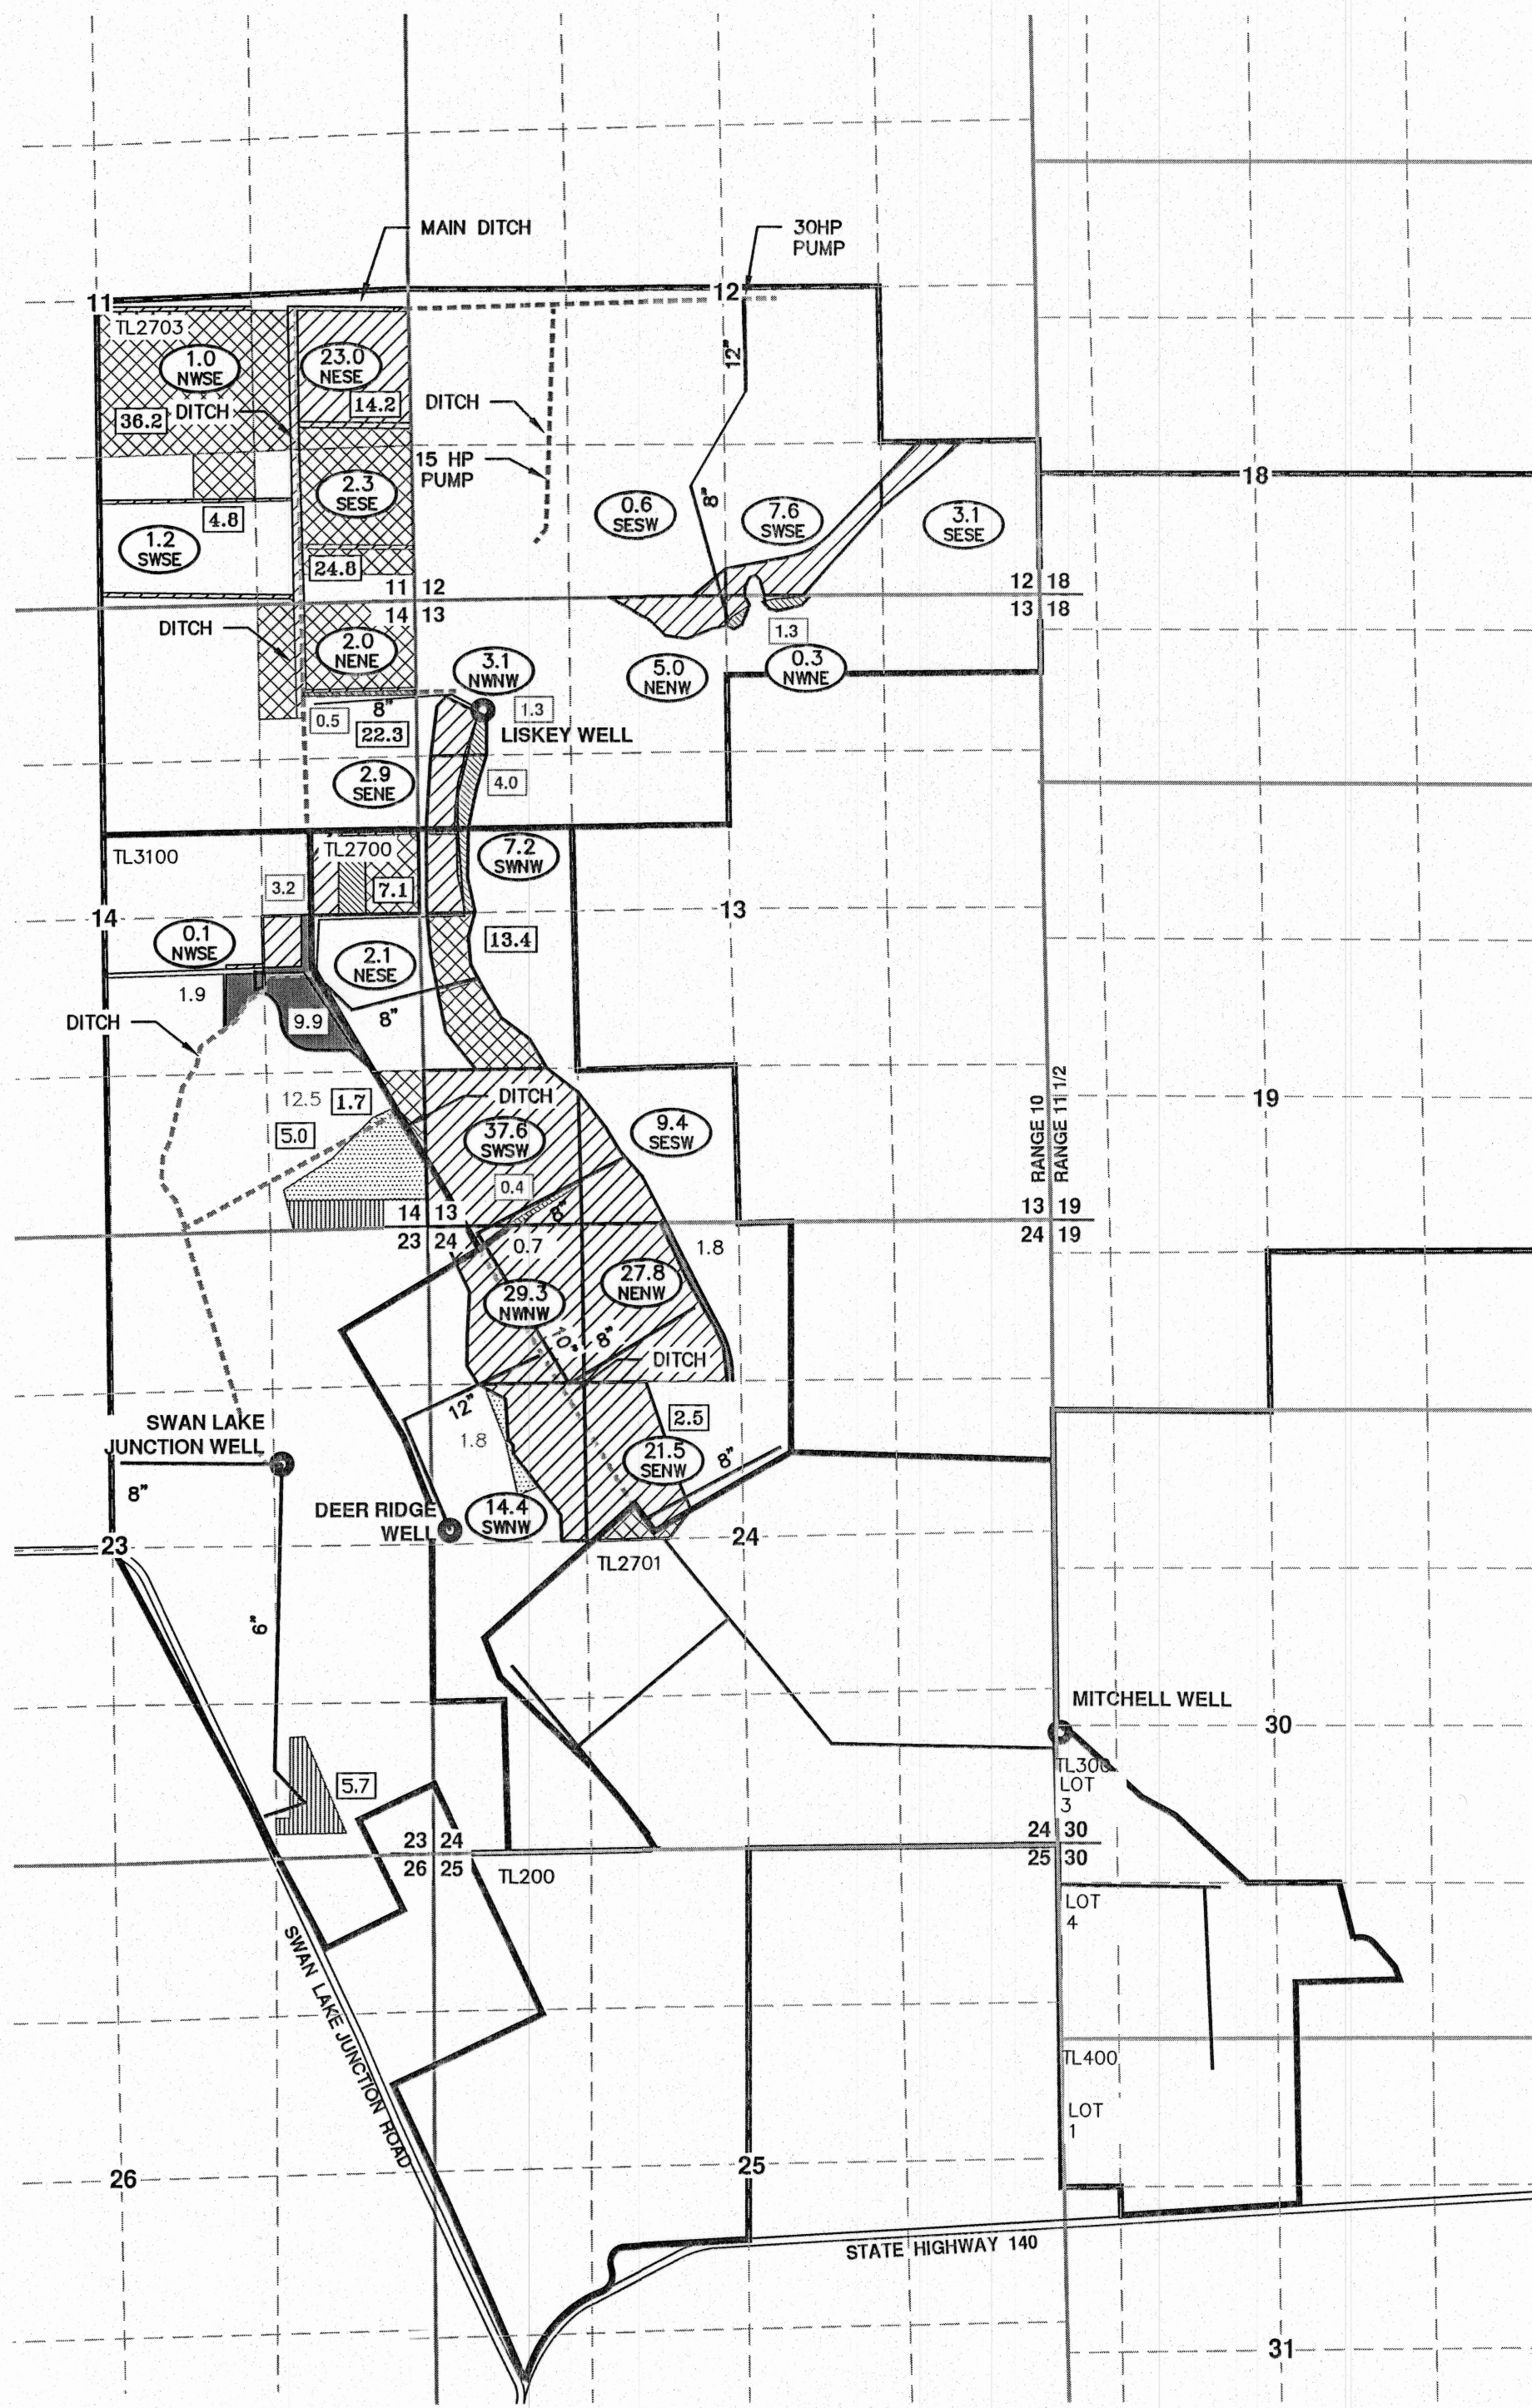

FINAL PROOF SURVEY


UNDER

APPLICATION NO. U-319, PERMIT NO. U-343

IN NAME OF

**NEVIN CATTLE CO.
GENE & VERA L. CARL
MIKE & BESSIE SHORT**

SURVEYED OCT. 6, 1965 BY R. JACKSON
JUN. 28, 1967 BY V. GARNER

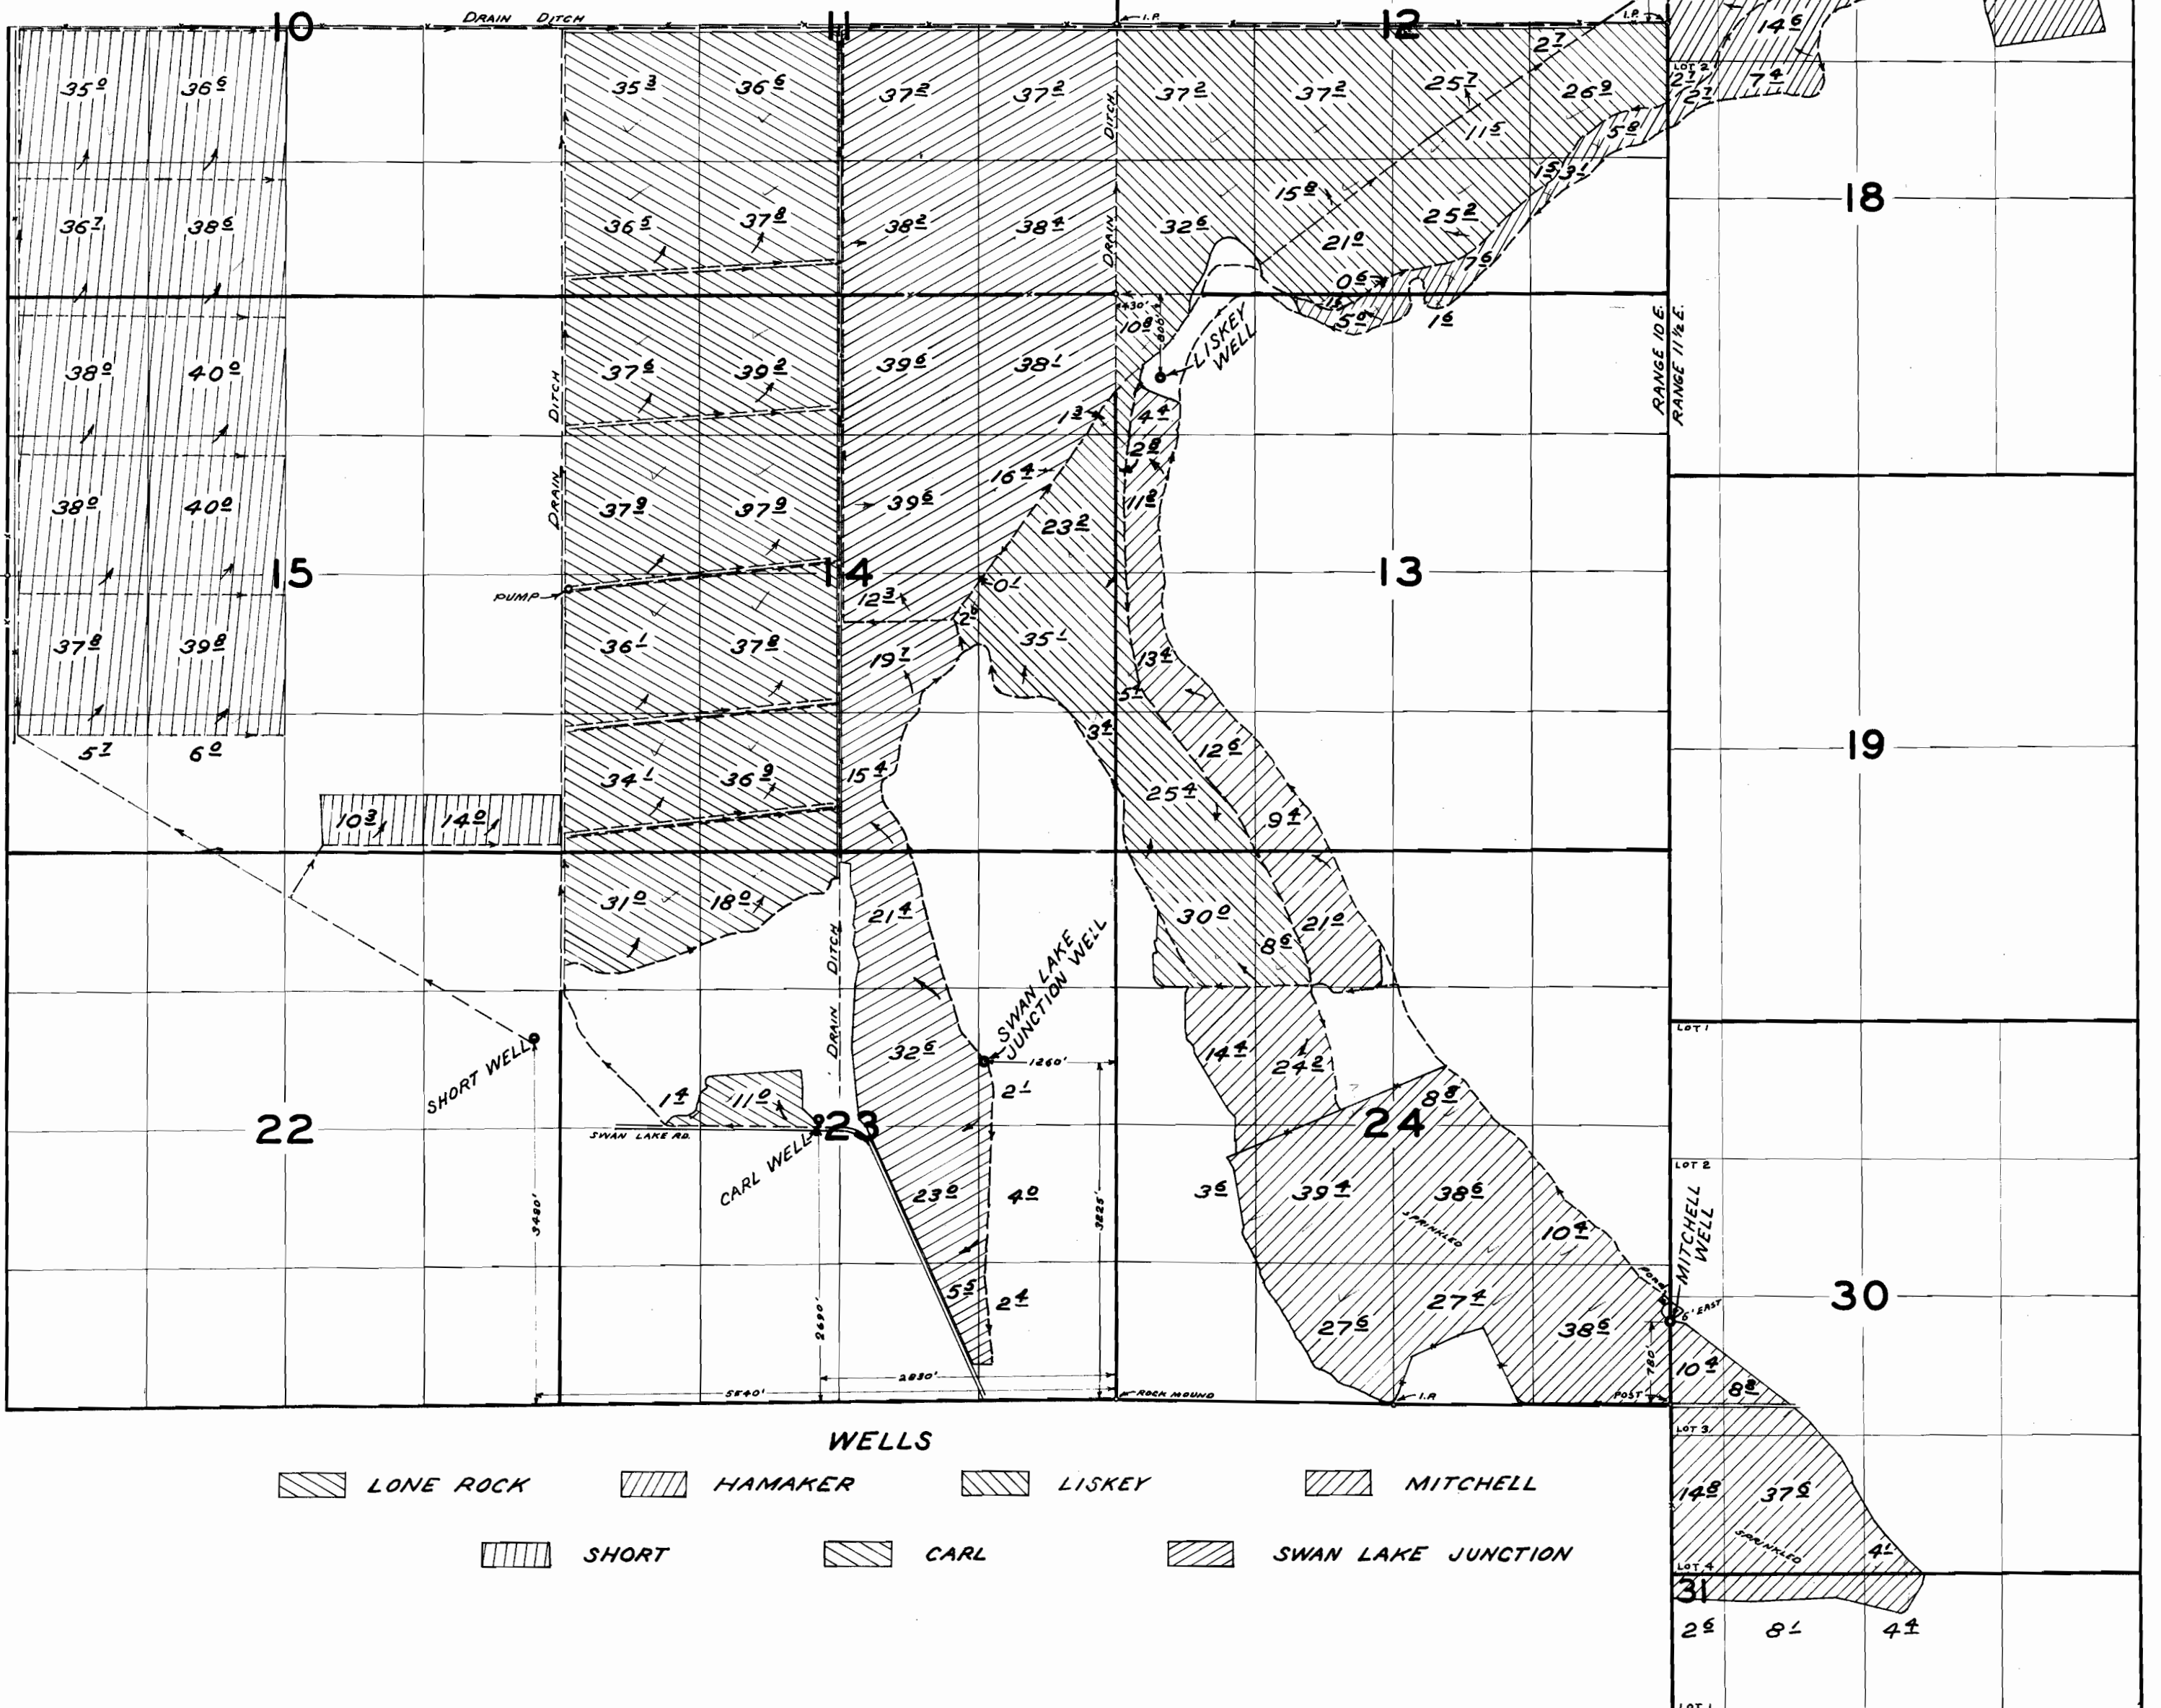

WELLS

- | | | | | | | | |
|--|-----------|--|---------|--|--------------------|--|----------|
| | LONE ROCK | | HAMAKER | | LISKEY | | MITCHELL |
| | SHORT | | CARL | | SWAN LAKE JUNCTION | | |