


# T.6 S., R.2W., W.M.

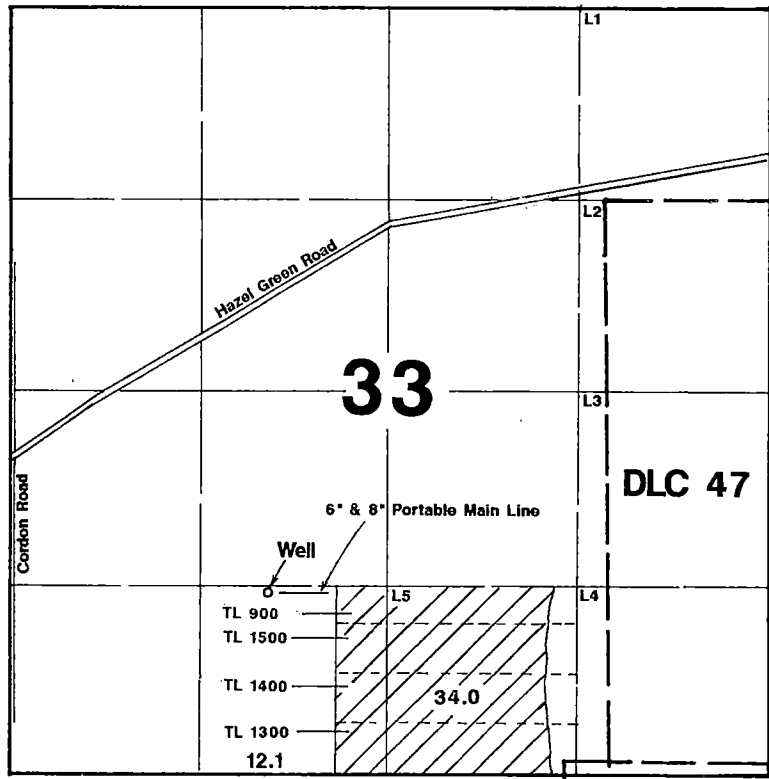

Well is located 1304' N & 1820' W from the SW corner of Section 33.

**RECEIVED**

**SEP 14 2005**  
**WATER RESOURCES DEPT**  
**SALIMA, OREGON**

## Final Proof Survey

In the Name of

# Myron Kuenzi

Application #: G-15033    Permit #: G-13949

Surveyed on January 13, 2004 by JM Schuette

This Map was Prepared for the Purpose of Identifying the Location of a Water Right Only and is Not Intended to Provide Legal Dimensions or Location of Property Ownership Lines.

