


T.5S. R.3W. Sec. 3, 4, 9, 10, and 16 W.M.

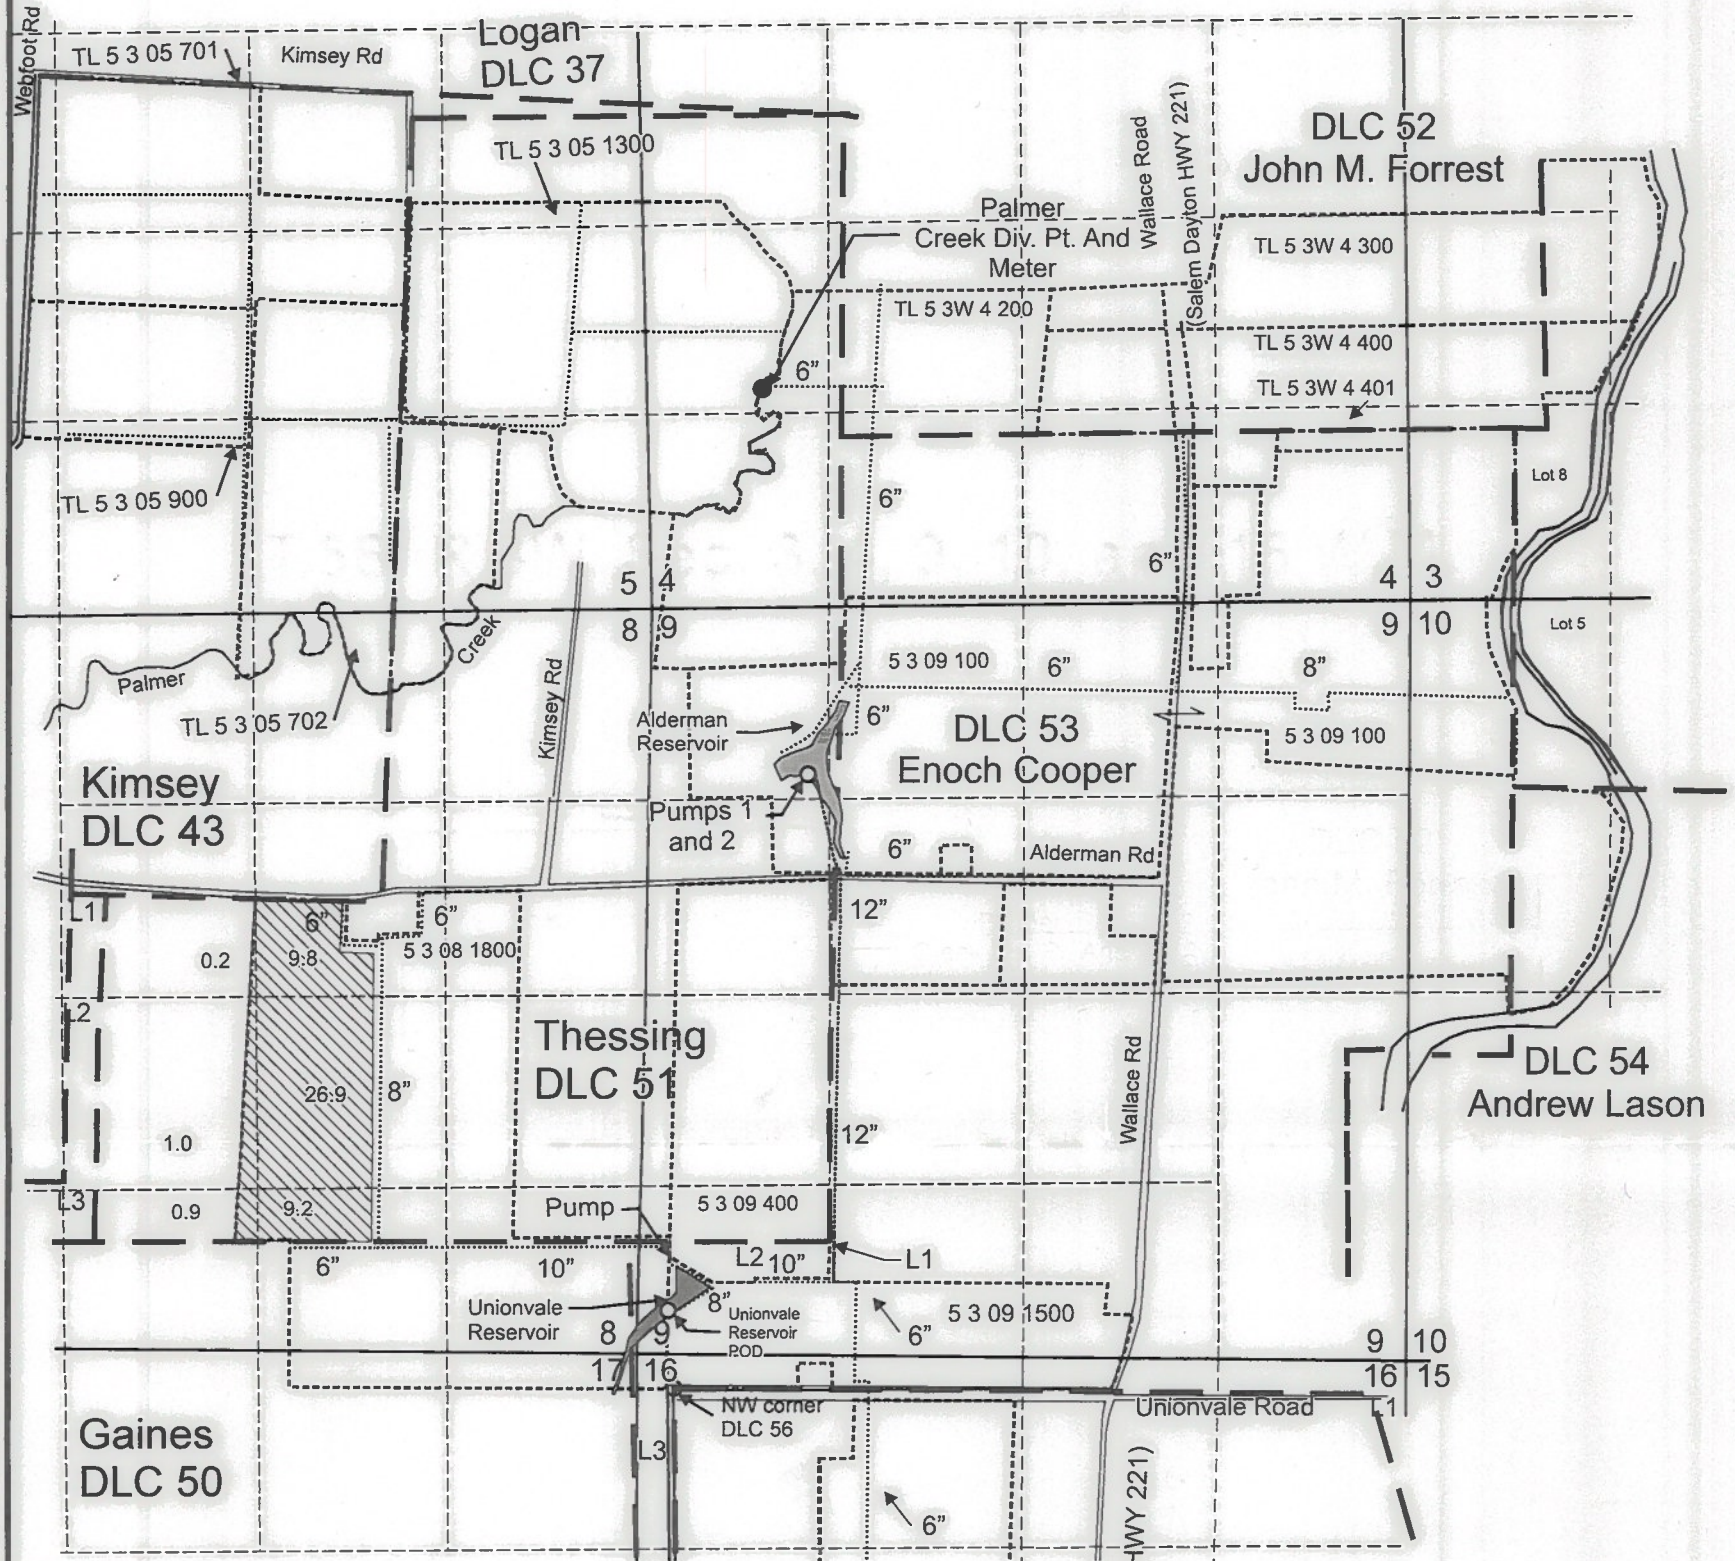

 Area (48.0 Acres) irrigated under Application S-72555, Permit S-54756..

----- Tax lot boundary

— • — Donation Land Claim boundary

..... Water main line



EXPIRATION DATE: 6/30/19



Scale: 1" = 1,320'



This map was prepared for the purpose of identifying the location of a water right only and is not intended to provide legal dimensions or location of property ownership lines.

Claim of Beneficial Use, Map2 of 2
Application S-72555, Permit S-54756

Carlton Nursery Co., LLC
T.5S. R.3W. Sec. 3, 4, 9, 10 and 16, W.M.

Pacific Hydro-Geology Inc.

1/2019