
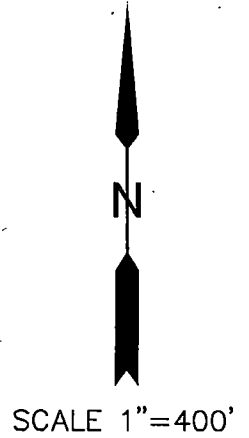


CLAIM OF BENEFICIAL USE SURVEY FOR
 APPLICATION S-84561 & PERMIT S-53894
 T33S R2E W.M. JACKSON COUNTY, OREGON
 TAXLOT 332E 11-2505

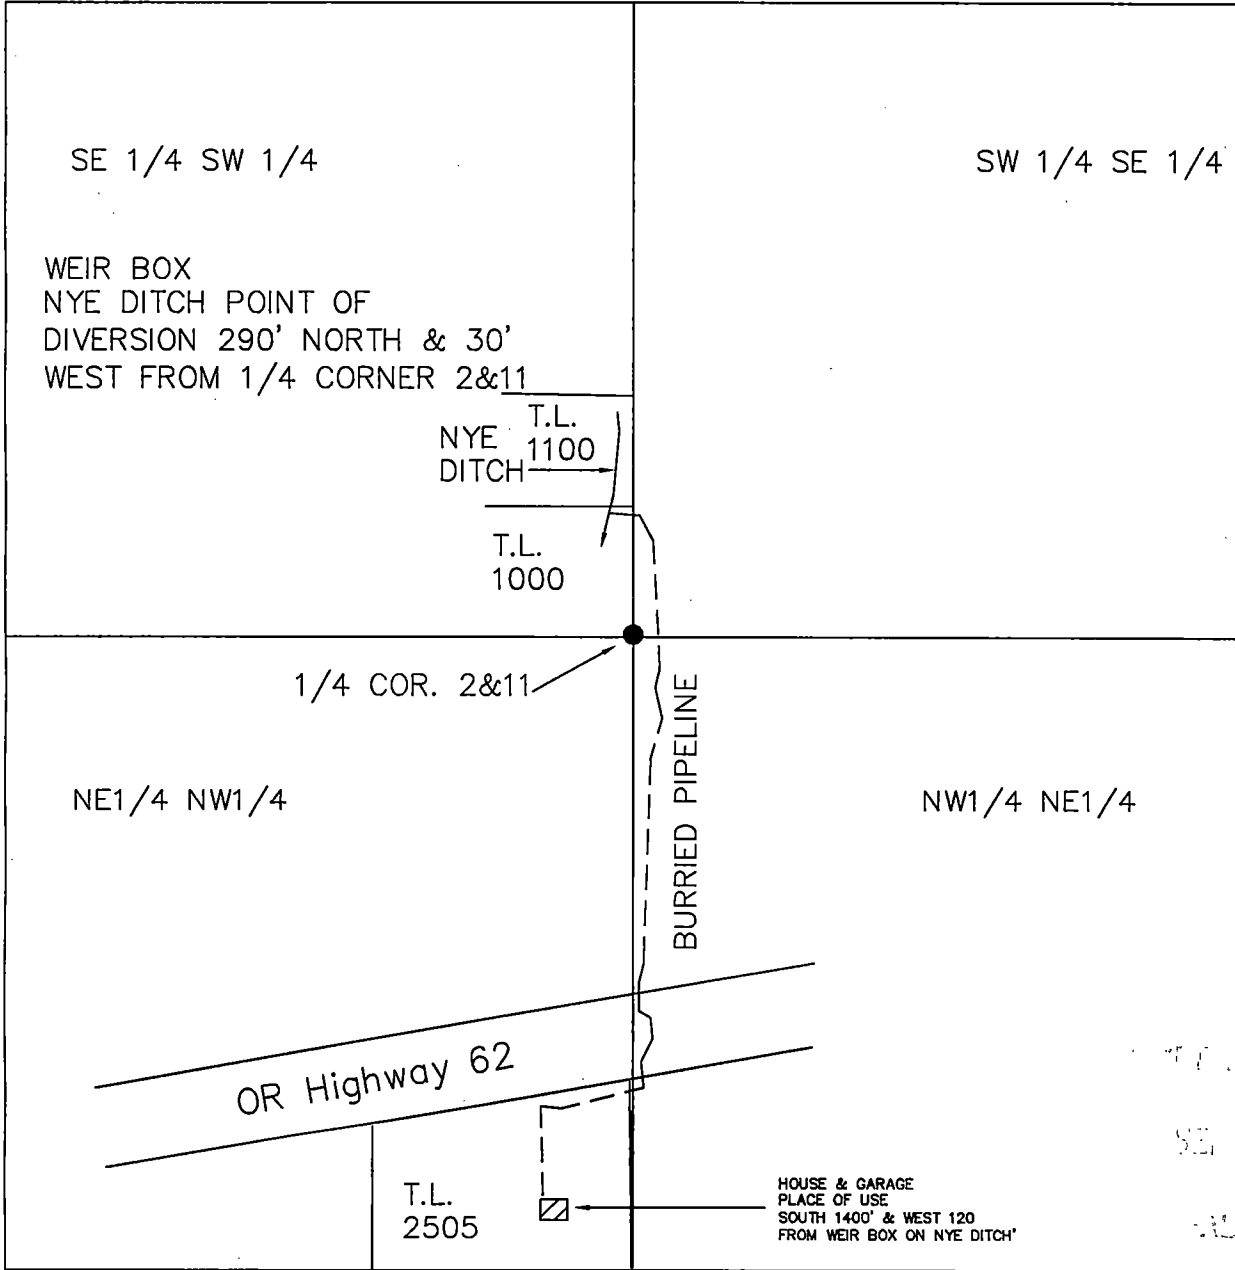


FOR WATER RIGHTS PURPOSES ONLY, NOT
 FOR PROPERTY BOUNDARY LOCATIONS.

NYE DITCH POINT OF DIVERSION
 T32S R3E W.M.

SURVEY FOR:
 BILL & JANET MATTHEWS
 1910 MILL CREEK DR.
 PROSPECT, OR 97536



SURVEY BY:
 SCOTT FEIN WATER RIGHTS
 SCOTT FEIN, CWRE
 600 TYLER CREEK RD.
 ASHLAND, OR 97520
 541-842-0795
 SFEINSURVEYOR@GMAIL.COM

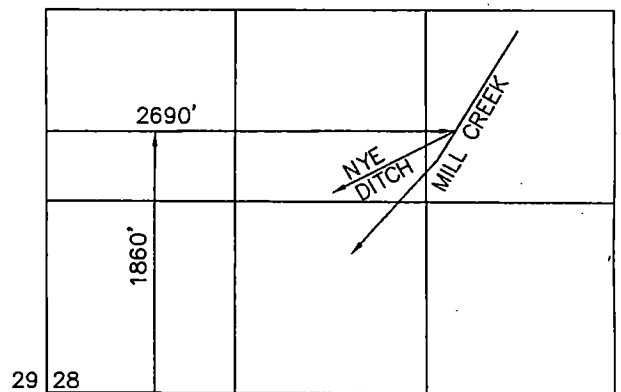

29 28
 32 33

SCALE 1"=1320'