


T 1 S R 38 E WM

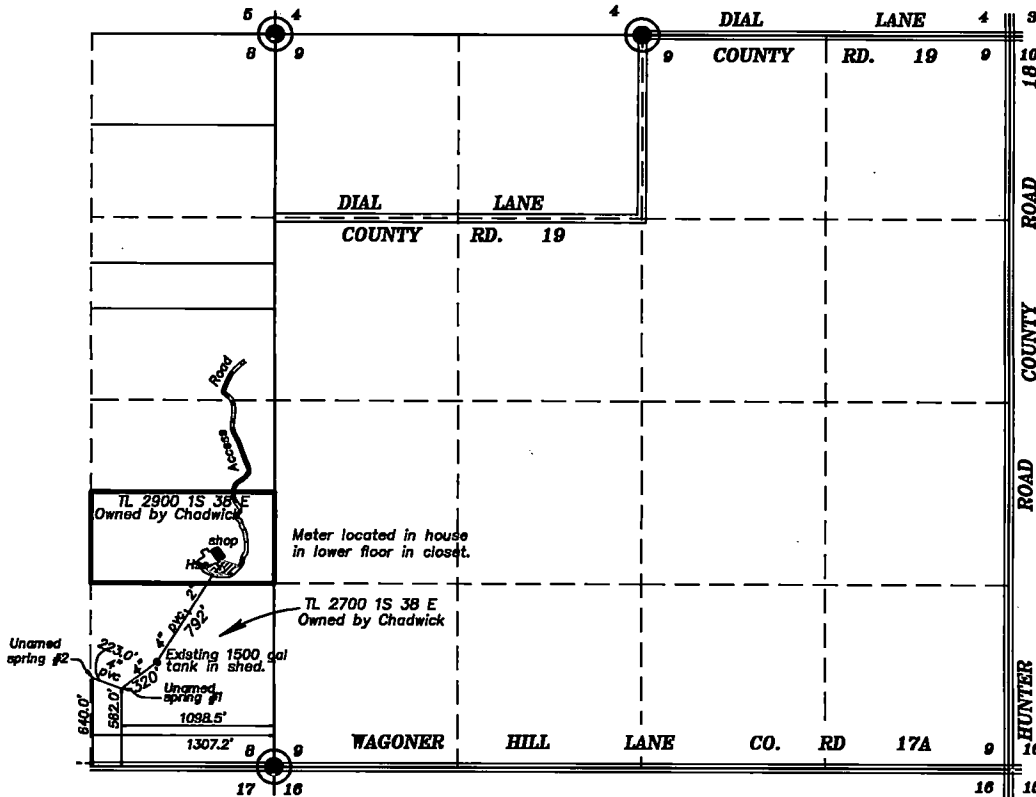

SCALE: 1"=1320'

Points of Diversion

Spring #1:

Lat: 45°29'13.74060" N

Long: 118°04'50.27232" W

N 562' & W 1098.2' from SE
cor Sec. 8 T1S R38E, WM.

Spring #2:

Lat: 45°29'14.51038 N

Long: 118°04'53.50110 W

N 640' & W 1307.2' from SE
cor Sec. 8 T1S R38E, WM



Yard being irrigated by springs as
applied for. Approximately 0.3 ac.


RECEIVED BY OWRD

JUL 08 2015

June 4, 2015

SALEM, OR

CLAIM OF BENEFICIAL USE
FOR DOMESTIC USE FOR ONE HOUSEHOLD
INCLUDING IRRIGATION OF LAWN AND GARDEN
NOT TO EXCEED 1/2 ACRE IN AREA

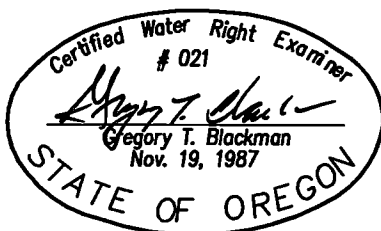

FOR
SHANE AND MARGIE CHADWICK

BY
GREG BLACKMAN WATER RIGHTS
126 RIDGE DRIVE
LA GRANDE, OREGON 97850

NOTE: The preparation of this map
was for the purpose of identifying
the location of the proposed water
right and has no intent to provide
dimensions or location of property
ownership lines. Location information
shown hereon was furnished by
the applicant.

APPLICATION NO.

S-83910

PERMIT NUMBER

S-53559