

APPLICATION - G-14124 PERMIT - G-12775

RECEIVED

FINAL PROOF SURVEY

SEP 16 1997

SEC. 7, T.15S., R.15E., W. M.  
CROOK COUNTY, OREGON


WATER RESOURCES DEPT.  
SALEM, OREGON

**WELL LOCATION**

IN NW1/4 SW1/4 ~ GOV. LOT 3

1405 FT. NORTH & 690 FT. EAST

OF SW COR. SEC. 7, T.15S., R.15E., W.M.

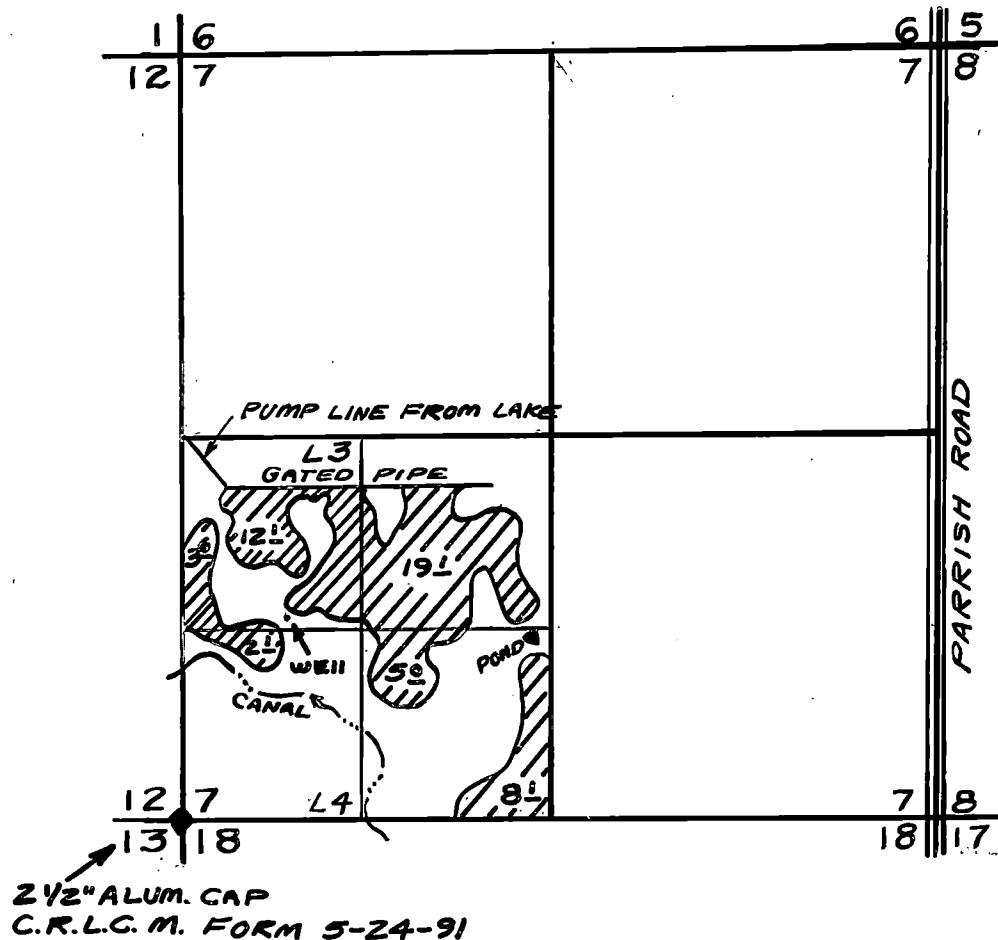

**MAP NOTE:**  
THE PREPARATION OF THIS MAP IS  
FOR THE PURPOSE OF IDENTIFYING  
THE LOCATION OF THE WATER RIGHT  
ONLY AND HAS NO INTENT TO PROVIDE  
DIMENSIONS OR LOCATIONS OF  
PROPERTY OWNERSHIP LINES.

PREPARED FOR

CHARLES R. MORGAN  
10460 S.W. CORNETT LP.  
POWELL BUTTE, OR

97753

LS41J 447-7989


*Renew 12/31/97*

**ARMSTRONG SURVEYING  
& ENGINEERING, INC.**

378 EAST SECOND STREET  
PRINEVILLE, OR 97754

LS41J 447-7791

SCALE: 1"=1320' AUG. 21, 1997

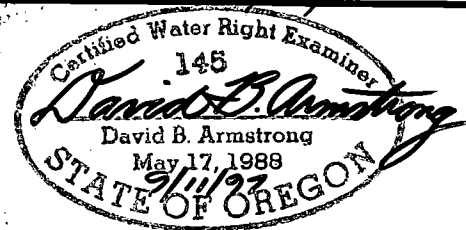

W.O. 97-1591