



1" = 400'


NOTE: THIS MAP IS NOT INTENDED TO PROVIDE LEGAL
DIMENSIONS OR LOCATIONS OF PROPERTY OWNERSHIP LINES.

RECEIVED BY OWRD

SEP 11 2012

SALEM, OR

POA - 570' NORTH, 730' WEST
OF SOUTH EAST CORNER

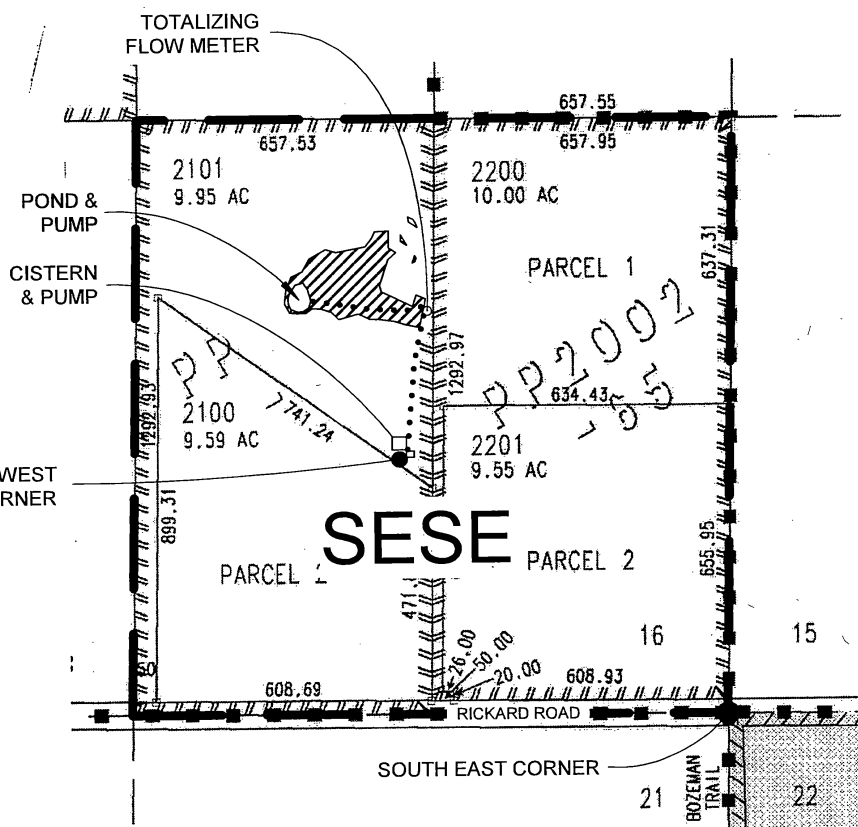

POU - IRRIGATION



QUARTER QUARTER
BOUNDARY



BURIED PIPELINE

DESCHUTES COUNTY, OREGON


**TOWNSHIP 18 SOUTH
RANGE 13 EAST,
WILLAMETTE MERIDIAN**

SECTION 16 (TAX LOT 2101)

SE 1/4 SE 1/4 0.75 IRRIGATED ACRES

APPLICATION G-16525

PERMIT G-16215

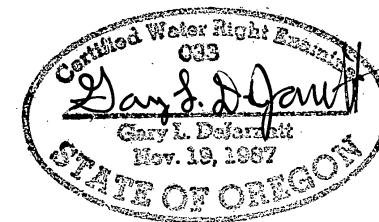

RENEWAL DATE: 12-31-2013

TITLE

**CLAIM OF BENEFICIAL USE MAP for
KATHY PAZERA**

WATER RIGHT SERVICES, LLC

WWW.OREGONWATER.US

P.O. BOX 1830, BEND OR 97709

(541) 389-2837 CCB# 197121

DATE

AUG 16, 2012

JOHNSHORT@USA.COM

JOB#

12044