


TOWNSHIP 19 SOUTH, RANGE 1 WEST, W.M.

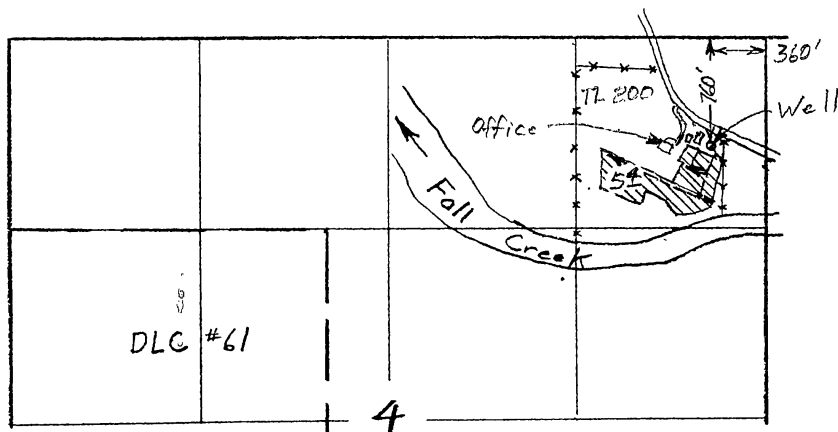

Scale 1"=1320'
(4"=1 mile)

⊗ Nursery Use 54 acres


Surveyed June 24, 2004

Claim of Beneficial Use Map
for

FALL CREEK FARM & NURSERY CO.
Dave Brazelton

Application. G-14713

Permit G-13521

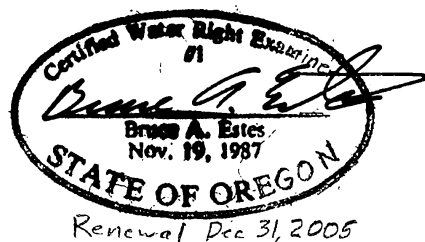

This map is for the purpose of
locating a water right only
and has no intent to provide
legal dimensions or the location
of property lines.

ESTES SURVEYS, LLC
PO Box 17519 60382 Arnold Rd
Salem, OR 97305-7519 Bend, OR 97702
(503) 565-7593 (541) 382-7391