

927

28

28 27

THIS MAP IS FOR THE PURPOSE
OF IDENTIFYING THE LOCATION
OF THE WATER RIGHT ONLY.
THERE IS NO INTENT TO PROVIDE
DIMENSIONS OR LOCATION OF
PROPERTY OWNERSHIP LINES.

NE 1/4, SE 1/4

NW 1/4, SE 1/4

CONDON CREEK

CONDON CREEK RD

RESIDENCE NO 1

SW 1/4, SE 1/4

TL 400

POD IS NORTH 711' & WEST 1563' FROM THE SE COR OF SEC 28

& FISH SCREEN

POD
PUMP HOUSE

SE 1/4, SE 1/4

1563'

METERS 1 & 2 ARE SOUTH 32' & EAST 63' FROM POD

PIPELINE

RESIDENCE NO 2

TL 404

711'

28

33

28 27

33 34

**CLAIM OF BENEFICIAL USE
WATER RIGHTS MAP
MID COAST BASIN
UNDER
APPLICATION S-87934
PERMIT S-54881**

SW 1/4, SE 1/4, SEC 28, T17S, R11W, W.M.
SE 1/4, SE 1/4, SEC 28, T17S, R11W, W.M.
17-11-28, T.L. 400 & 404
LANE COUNTY, OREGON


RECEIVED BY OWRD

FOR: BYRON AND SUSAN DEVRIES
89060 CONDON CREEK RD
FLORENCE, OR 97439

JUL 13 2015

SALEM, OR

PREPARED BY: WOBBE & ASSOCIATES, INC.
510 KINGWOOD ST. / P.O. BOX 3093
FLORENCE, OR 97439
DATE: FEBRUARY 18, 2015

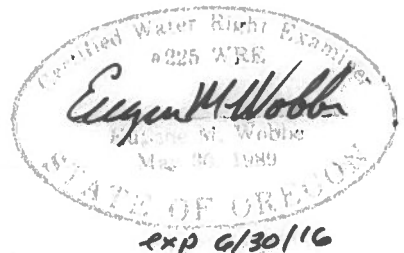

COB W MAP 927

