

# Claim of Beneficial Use Map, Transfer T-12436 A Water Right in the Name of T & K, LLC


PAGE 1.0

FEB 01 2019

Clackamas County, Oregon


Township 2 South, Range 3 East (W.M.)

OWNER

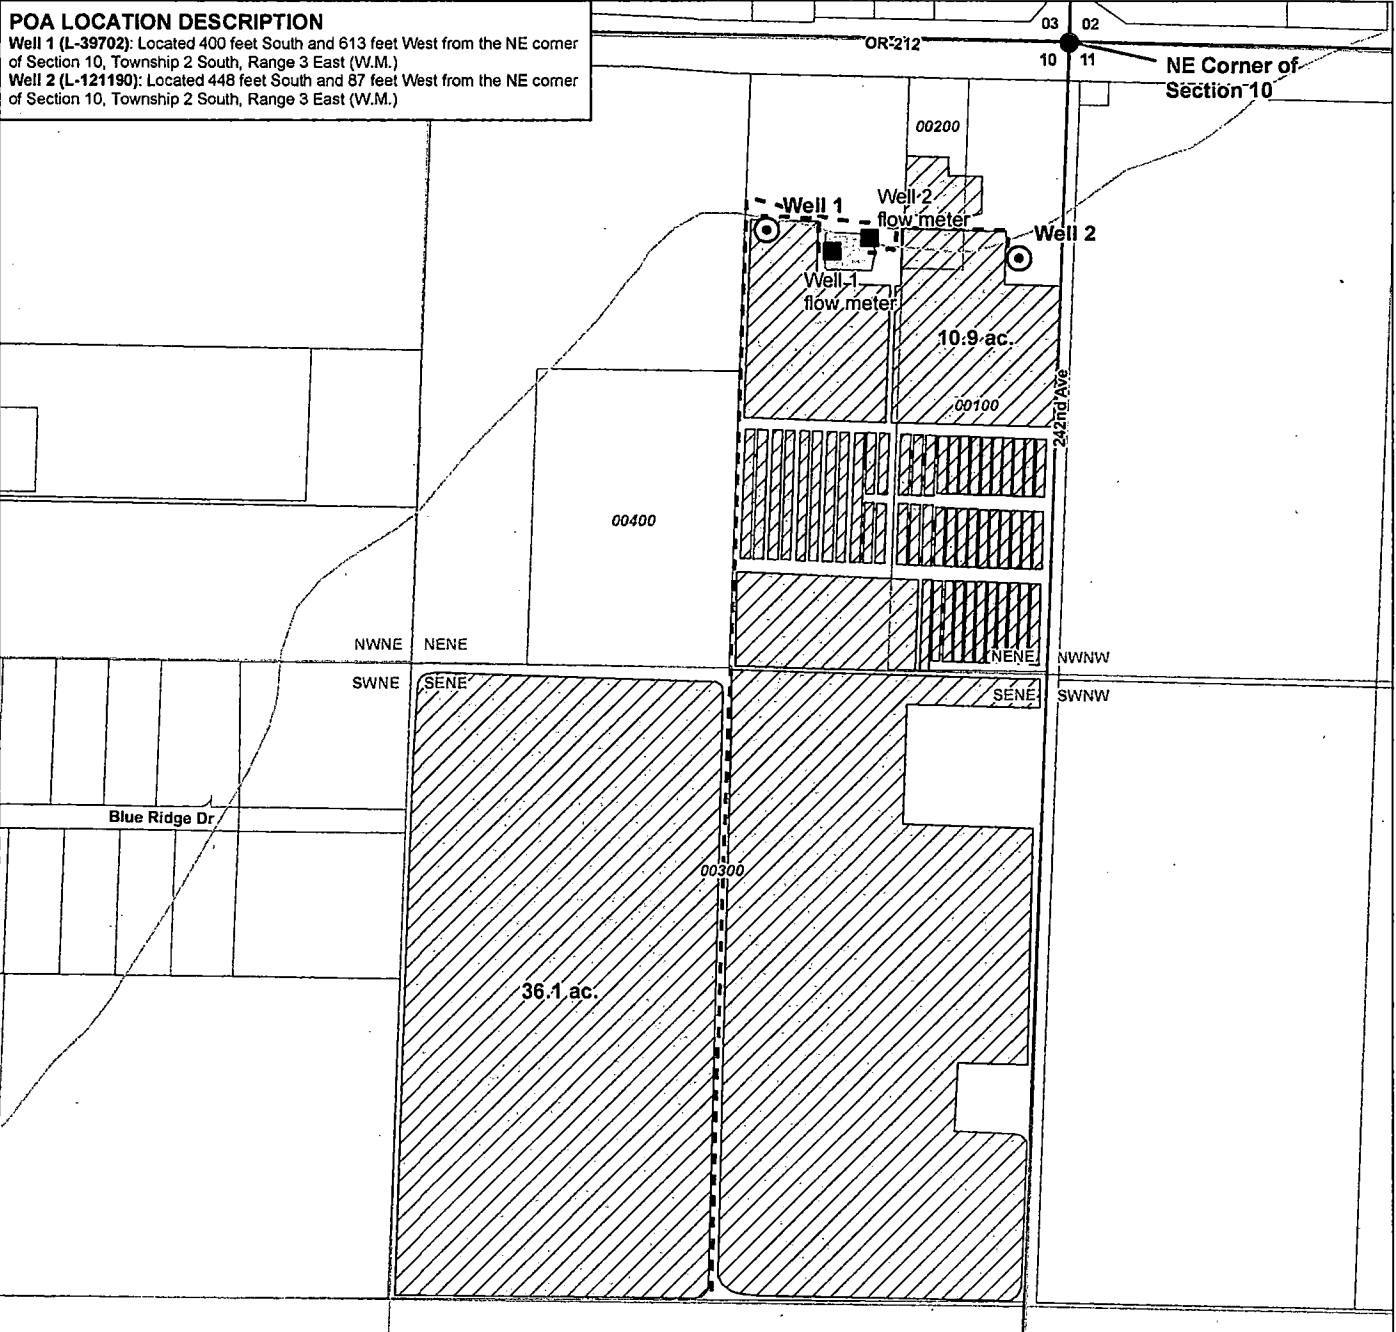

Document Path: Y:\3731\_TandK\_LLC\Source\_Figures\01\_Hwy212\_Ministry\COBU\_T12436.mxd

- LEGEND**
- ⊙ Point of Appropriation (POA)
  - Flow Meter
  - - - Mainline
  - ▨ Bulge
  - ▨ Place of Use (POU)
  - All Other Features**
  - ⊕ Tax Lot
  - ~ Watercourse

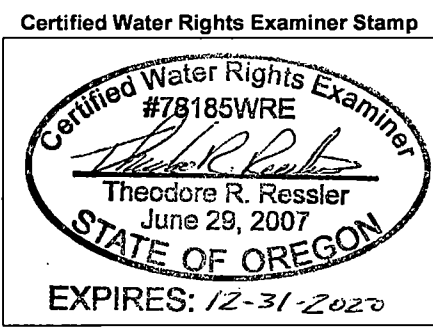

**DISCLAIMER**  
 This map was prepared for the purpose of identifying the location of a water right only and it is not intended to provide legal dimensions or location of property ownership lines.

**MAP NOTES**  
 Date: January 22, 2019  
 Data Sources: METRO, ESRI, USGS

