

T. 23 S., R 12 W., W.M.


LEGEND

- SECTION AND PROPERTY BOUNDARIES
- 3/4" PVC WATER LINE
- UN-NAMED STREAM
- ⊙ POINT OF DIVERSION

This map is not intended to provide legal dimensions or locations of property ownership lines.



MAP 23 12 10BB

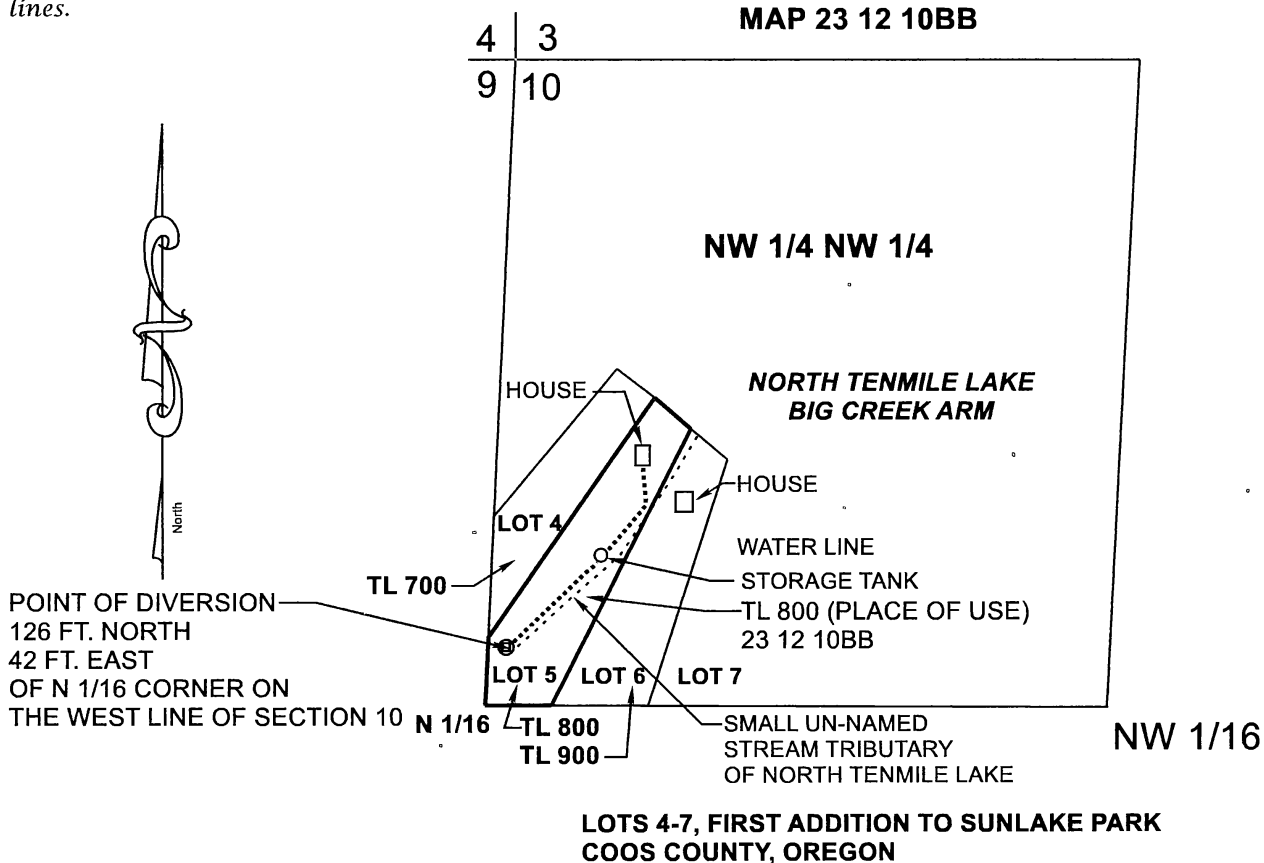

POINT OF DIVERSION

DIV. PT. LOCATED 126 FT. NORTH & 42' EAST,
FROM THE N 1/16 CORNER ON THE WEST
LINE OF SECTION 10

SCALE: 1"=400'

FINAL PROOF SURVEY

UNDER

Application No. S-85102 Permit No. 53872

IN THE NAME OF

KAREN GREEN

Surveyed November 17, 2015, by T.HOSTETTER

RECEIVED

JAN 21 2016

COOS COUNTY CLERK