


T. 23 S., R 12 W., W.M.

LEGEND

- SECTION AND PROPERTY BOUNDARIES
- 3/4" PVC WATER LINE
- UN-NAMED STREAM
- ⊕ POINT OF DIVERSION

This map is not intended to provide legal dimensions or locations of property ownership lines.

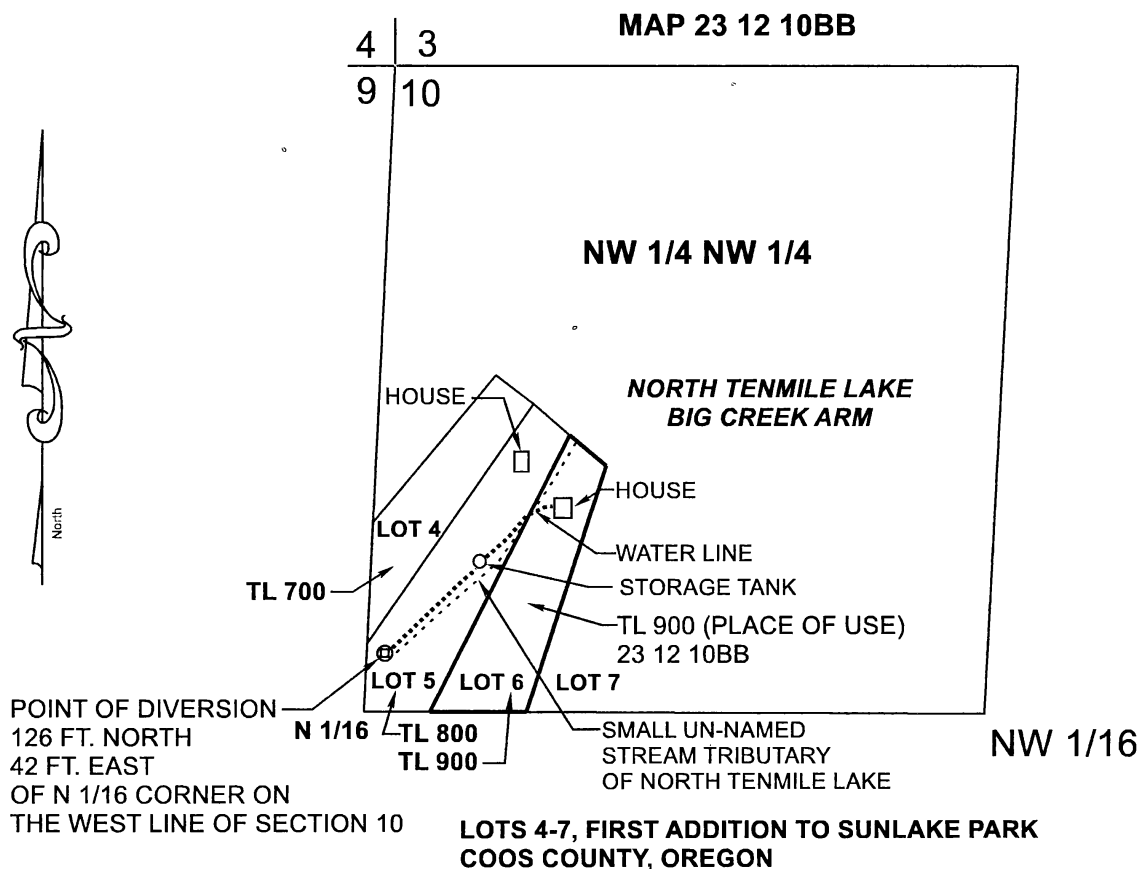

POINT OF DIVERSION

DIV. PT. LOCATED 126 FT. NORTH & 42' EAST,
FROM THE N 1/16 CORNER ON THE WEST
LINE OF SECTION 10

SCALE: 1"=400'

FINAL PROOF SURVEY

UNDER

Application No. S-85216 Permit No. 53874

IN THE NAME OF

RUSSELL AND MARY INSCORE

Surveyed November 17, 2015, by T.HOSTETTER

RECEIVED BY OWRD

DEC 09 2015

SALEM, OR