

COBU MAP # 890

MAP FOR CLAIM OF BENEFICIAL USE FOR JONATHAN HOLDAWAY


APPLICATION : G-17298 / PERMIT G-16803
SE1/4, SE1/4 SECTION 16, T38S, R10EWM,
KLAMATH COUNTY, OREGON
FEBRUARY, 2015

LEGEND

- O#2 DOMESTIC/ WELL #2: 1754' EAST/
1995' SOUTH FROM CENTER SEC. 16
- O#1 IRRIGATION/ WELL #1: 1564' EAST/
1980' SOUTH FROM CENTER SEC. 16
(KLAM 50493)
- ▽ STANDPIPE W/ VALVE (5 TOTAL)
- GPI FLOW METER-TMS SERIES
- DATE OF PRIORITY: 1/15/2010
SITE ADDRESS: 3660 SWAN LAKE ROAD
KLAMATH FALLS, OR 97603
- 2" UNDERGROUND PVC MAIN LINE
(780' ±)
- ▨ 4.80 IRRIGATED ACRES

RECEIVED BY CWRD
MAR 02 2015
SALEM, OR

THE PURPOSE OF THIS MAP IS TO IDENTIFY THE LOCATION OF
THE WATER RIGHT APPLICATION. IT IS NOT INTENDED TO
PROVIDE INFORMATION RELATIVE TO THE LOCATION OF PROPERTY
OWNERSHIP BOUNDARY LINES.

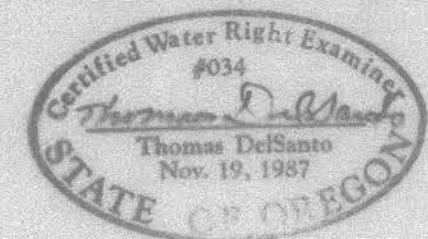

FINAL PROOF SURVEY BY:
THOMAS DEL SANTO, PLS, CWRE
6326 KATIE LANE
KLAMATH FALLS, OR 97603
541.891.9017

MAP PREPARED BY:
TRU SURVEYING, INC. LINE
2333 SUMMERS LANE
KLAMATH FALLS, OREGON 97603

CENTER
SEC. 16

1564'

SE 1/4 SEC. 16

1980'
TO WELL #1
IRRIGATION

SE1/4 - SE1/4

SWAN LAKE ROAD 60' R/W

BARN

#1

#2

DRIVEWAY

T38S - R10E - SEC 16 - TAX LOT 3301

16 15
21 22



SCALE
1" = 200'



890