

RECEIVED BY OWRD


OCT 26 2015

Claim of Beneficial Use Map

Permit R-12879, Application R-84323
Water Right in the Name of Roseburg Forest Products
County of Douglas

Township 30 South, Range 6 West (W.M.)

SALEM, OR

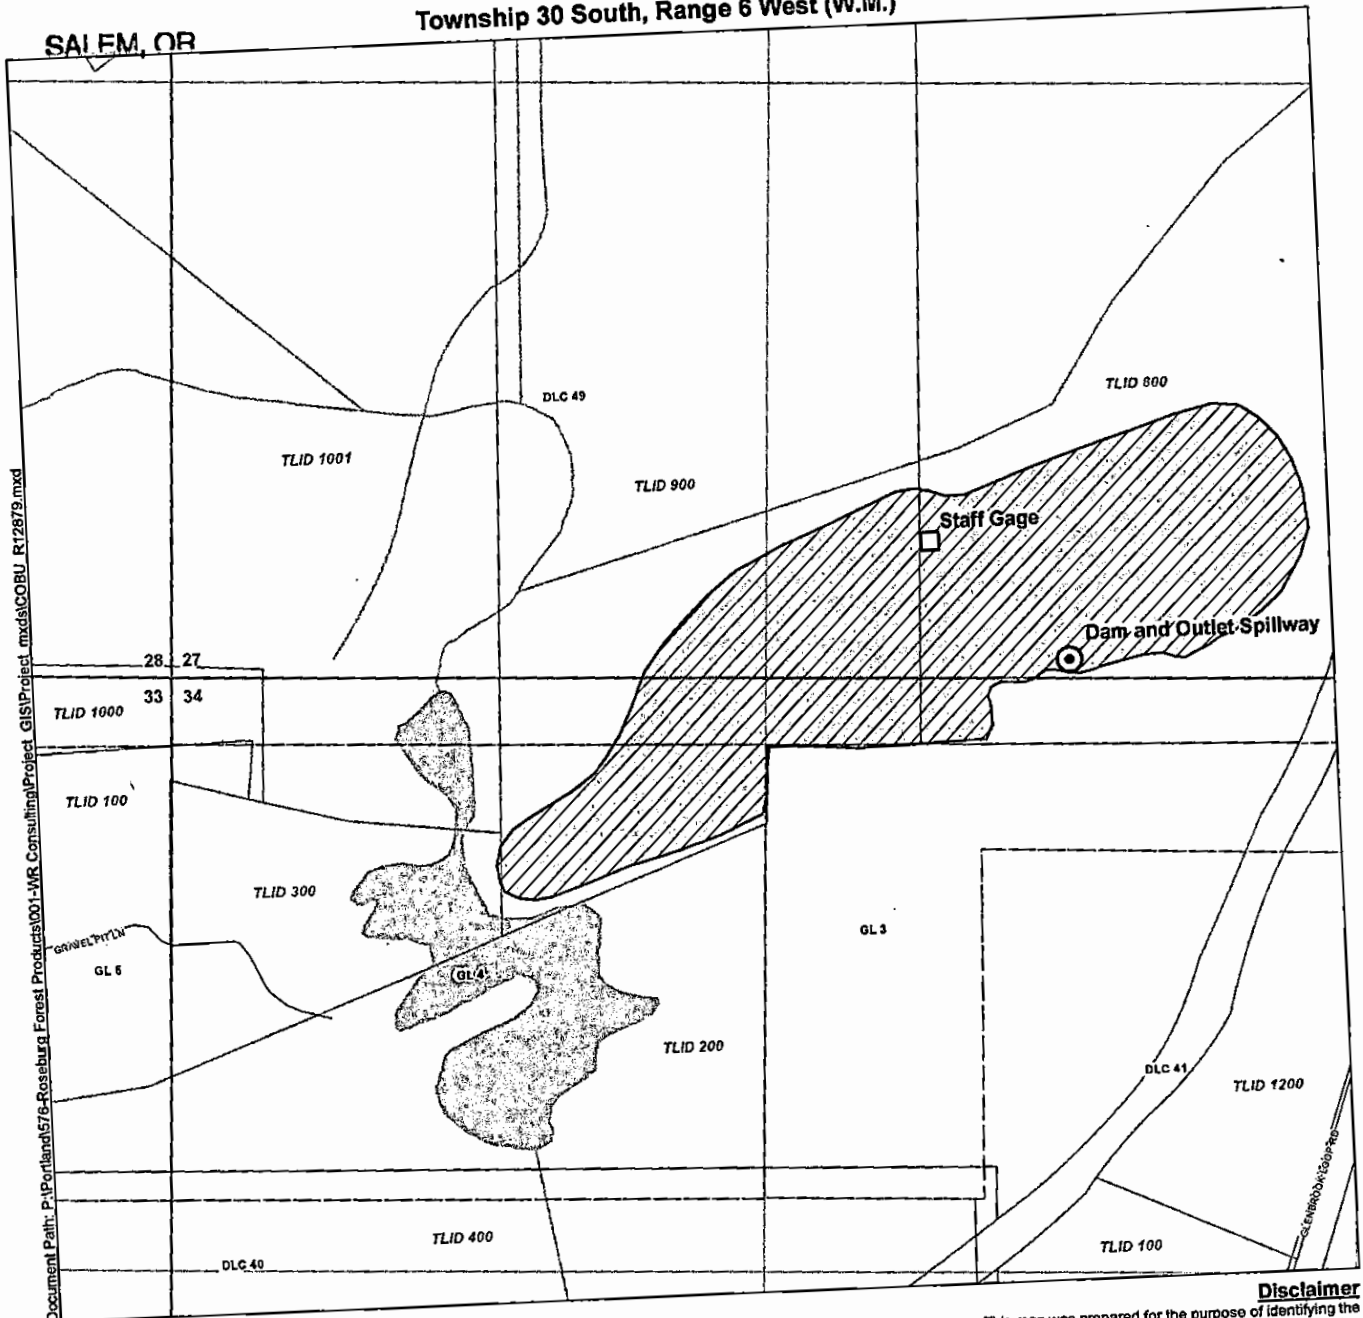

Document Path: P:\Portland\578-Roseburg Forest Products\001-MR_Consulting\Project_GIS\Project_mxd\COBU_R12879.mxd


LEGEND

- Point of Diversion (POD)
- Staff Gage
- Place of Use (POU)
- Donation Land Claim (DLC)
- Government Lot (GL)
- Tax Lot
- Major Road
- Watercourse
- Waterbody

POD Location Description

Point of Diversion
Located 45 feet North and 2,000 feet East from the SW corner
of Section 27, Township 30 South, Range 6 West (W.M.)

Certified Water Rights Examiner Stamp

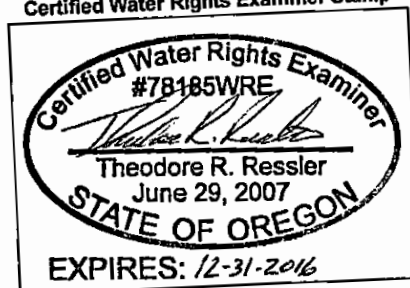

Disclaimer

This map was prepared for the purpose of identifying the location of a water right only and it is not intended to provide legal dimensions or location of property ownership lines.

Map Notes

Date: October 8, 2015
Data Sources: BLM, USGS, ESRI
Prepared By: GSI Water Solutions, Inc.

