


FINAL PROOF MAP
 PERMIT S-53689 - APPLICATION S-84159
 NW1/4NE1/4 SECTION 36, T.40S., R.1E., W.M.
 JACKSON COUNTY, OREGON
 FOR
 JOHN P. NUSSBAUMER
 P.O. BOX 3241 - 1757 Colestin Road
 ASHLAND, OR 97520




Scale: 1"=200'
 Date: Oct. 2, 2015

LEGEND

- Found Survey Monument
- Denotes Household
- ⊙ Denotes Garden Area
Permit S-53689
5/24/1999 Priority Date
- - - Denotes Pipeline
- △ Denotes Point of Diversion
- ⊙ Denotes Storage Tank
- ⊙ Denotes Fish Screen
- — Denotes 1/4 Section Line

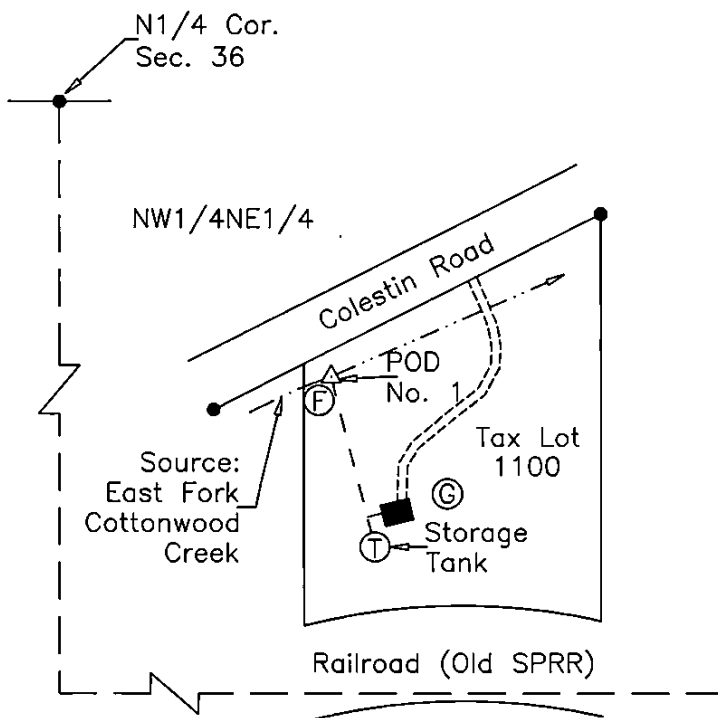

Point of Diversion No. 1, South 962' and East 463' from the North 1/4 Corner Section 36. Fish screen at Point of Diversion.

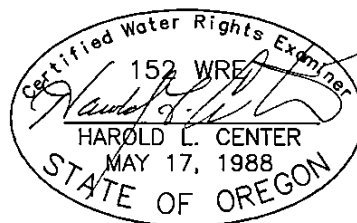

Renews: 12/31/15

This map was prepared for the purpose of identifying the location of a water right only and is not intended to provide legal dimensions or location of property ownership.

RECEIVED BY OWRD

HAROLD L. CENTER
 2604 David Lane
 Medford, OR. 97504
 Phone 541-535-6108
 Oregon Certificate No. 152

OCT 19 2015

SALEM, OR