

T.4S. R.2W. Sec. 30 & 31 and R.3W. Sec. 25 & 36, W.M.

Authorized Well 5 (MARI 1446) is located 570 feet north and 440 feet west from the SE corner, DLC 65.


Well 2 (MARI 66297) is located 435 feet south and 985 feet east from the SW corner, Section 30.

 Area (57.0 Acres) of supplemental irrigation under T-12117

— . Donation Land Claim boundary

- - - - Tax lot boundary

..... Irrigation mainlines

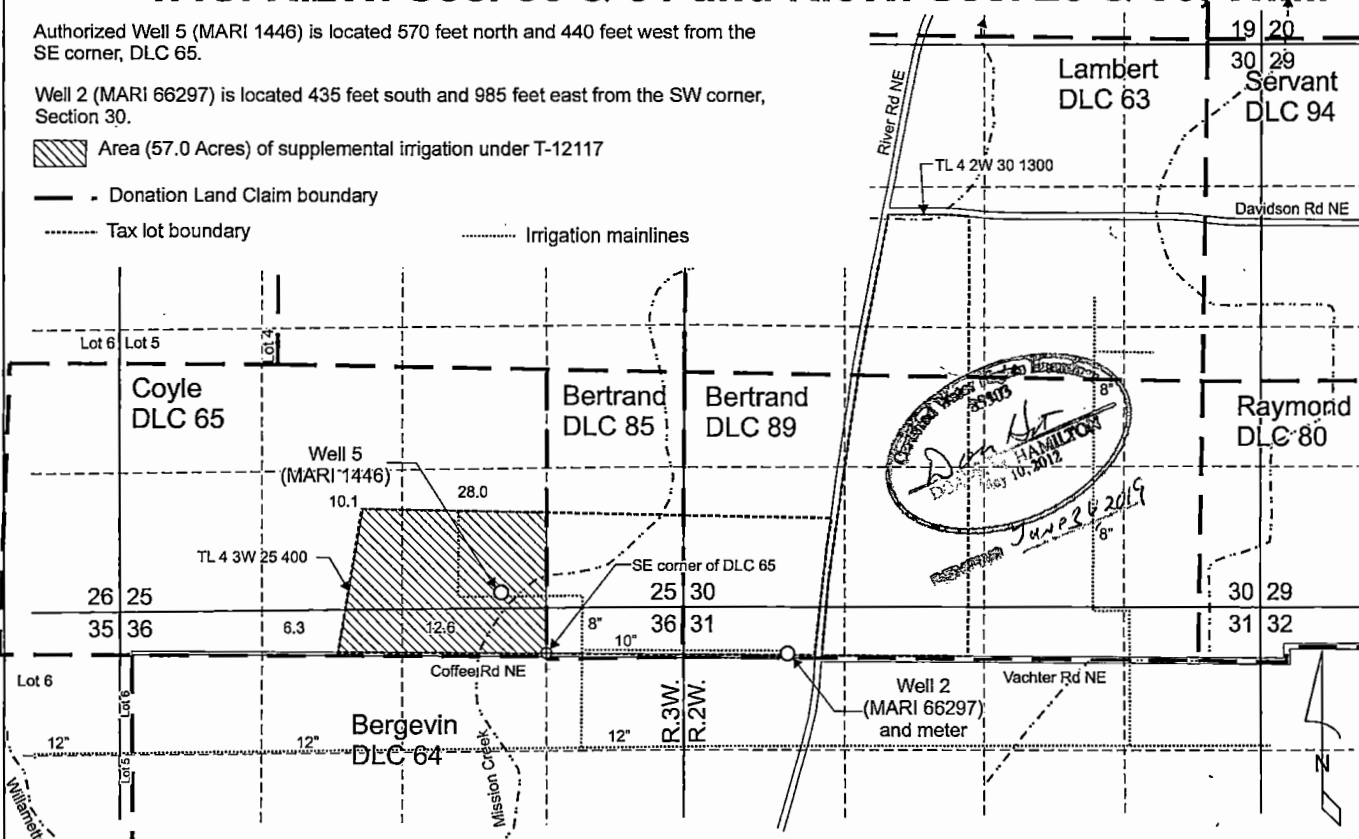




 David Hamilton

 Surveyor

 June 26 2019

DavidsonT-12117COBU.cdr

Scale: 1" = 1,320'

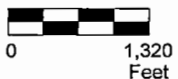

This map was prepared for the purpose of identifying the location of a water right only and is not intended to provide legal dimensions or location of property ownership lines.

Pacific Hydro-Geology Inc.

Claim of Beneficial Use Map
 T-12117
 Mike Davidson
 T.4S. R.2W. Sec. 30 & 31 and
 T.4S. R.3W. Sec. 25 & 36, W.M.

02/2019