

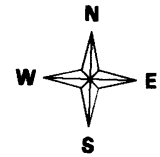


CLAIM of BENEFICIAL USE MAP
FOR: RICHARD W. & ETHELYN BARRETT
BY: NATHAN R. REED, CWRE
T28S, R6W, W.M. SECTION 3
APPLICATION NO. S-84880
PERMIT NO. S-53868

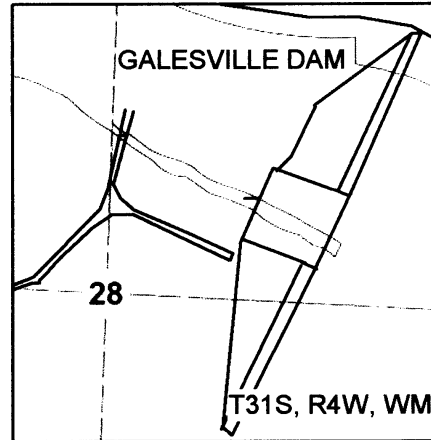

Scale: 1" = 400'

DATE SURVEYED: SEPTEMBER 12, 2015

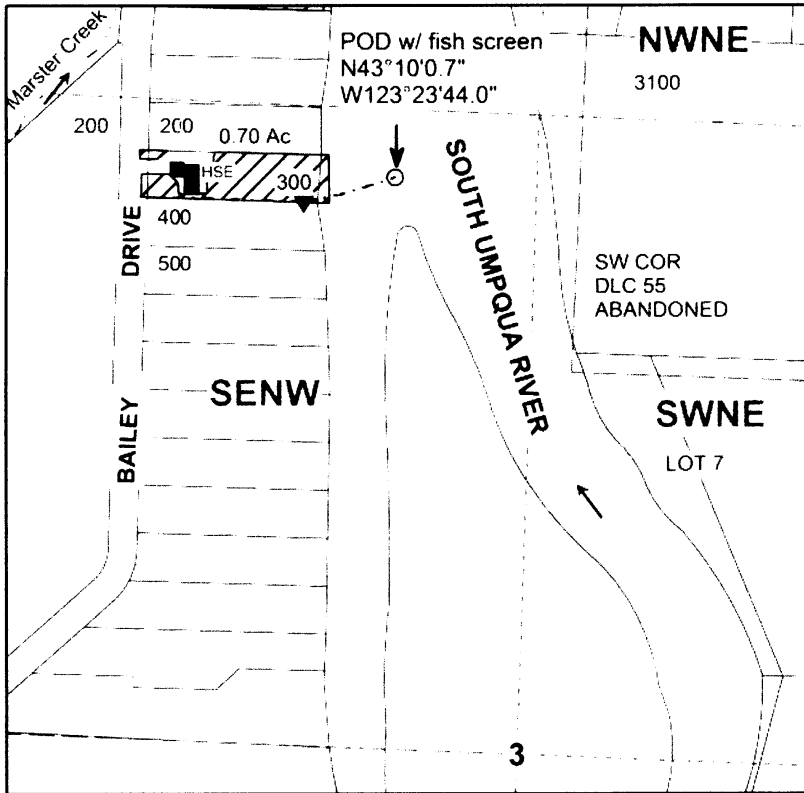

RECEIVED BY OWRD


POD IS LOCATED 1120 FEET NORTH AND 277 FEET WEST OF THE C1/4 OF SECTION 3.

SEP 23 2015

SALEM, OR

Legend

○	POD	■	Structure	□	DLC
▼	Pump	---	Stream	---	Quarter
---	Pipeline	→	Flow Arrow	---	Sixteenth
▨	Irrigation	---	Gov Lot	□	Parcels

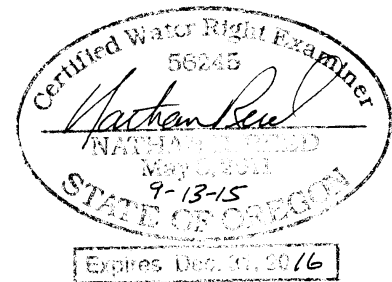

MAP PREPARED FOR:
 RICHARD W. & ETHELYN BARRETT
 429 BAILEY DRIVE
 ROSEBURG, OR 97471

MAP PREPARED BY:
 NATHAN R. REED, P.E., CWRE
 1113 SE CASS AV
 ROSEBURG, OR 97470

THE PURPOSE OF THIS MAP IS TO IDENTIFY THE LOCATION OF THE WATER RIGHT. IT IS NOT INTENDED TO PROVIDE INFORMATION RELATIVE TO THE LOCATION OF PROPERTY OWNERSHIP BOUNDARY LINES.