
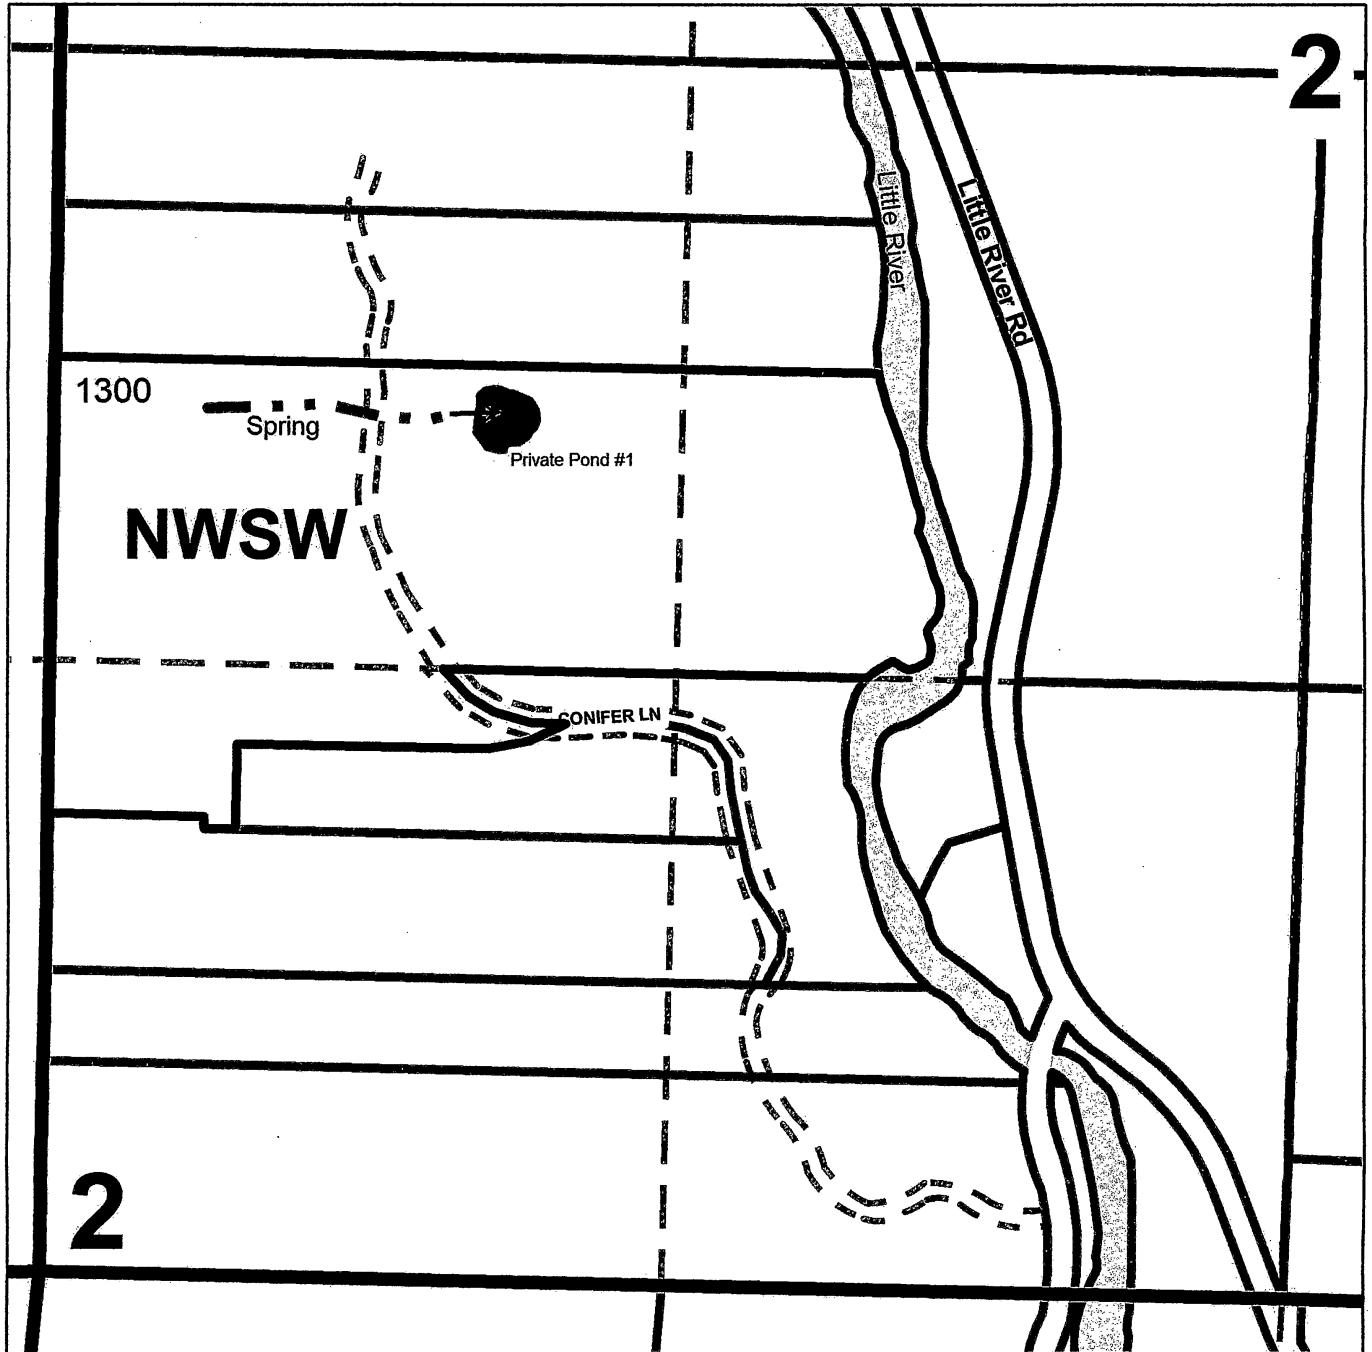


James Hanson Private Pond #1
T.27S. R.3W. Sec. 2
Douglas County
Scale: 1" = 400'

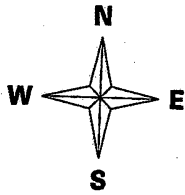

**Pond is located 700 ft. South and 950 ft. East from
the West Quarter Corner of Section 2.**

RECEIVED
AUG 16 2018
OWRD