




# T.6S. R.1W. Sec. 31 & 32, W.M.

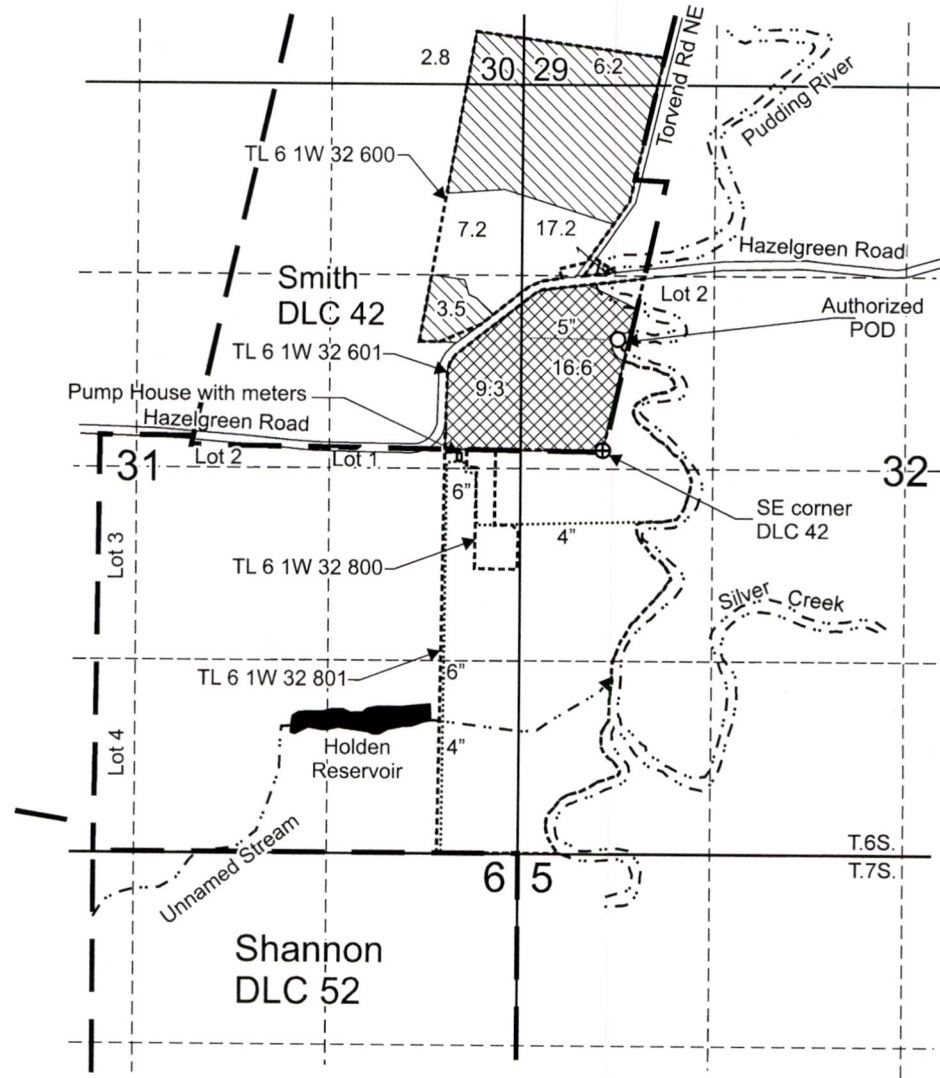




RECEIVED  
MAY 16 2019  
OWRD

83303  
DOANN M. HAMILTON  
May 10, 2012  
JUN 30 2019

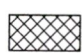Authorized POD is located 760 feet north and 100 feet east from the SE corner, DLC 42.

-  "From" Area (25.9 Acres) irrigated under Certificate 40143, priority date May 13, 1968, affected by this transfer.
-  Area (37.1 Acres) irrigated under Certificate 40143, priority date May 13, 1968, not affected by this transfer.


-  Tax lot boundary
-  Donation Land Claim boundary
-  Water main line

RECEIVED

MAY 02 2019

OWRD

This map was prepared for the purpose of identifying the location of a water right only and is not intended to provide legal dimensions or location of property ownership lines.

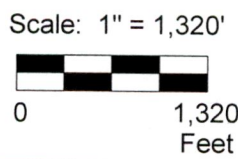

Pacific Hydro-Geology Inc.

04/2019


Transfer Application "From" Map  
Certificate 40143

Steven V. and Constance A. Johnson  
T.6S. R.1W. Sec. 31 & 32, W.M.


13182


JohnsonCert 40143TransMap.cdr

# T.6S. R.1W. Sec. 31 & 32, W.M.

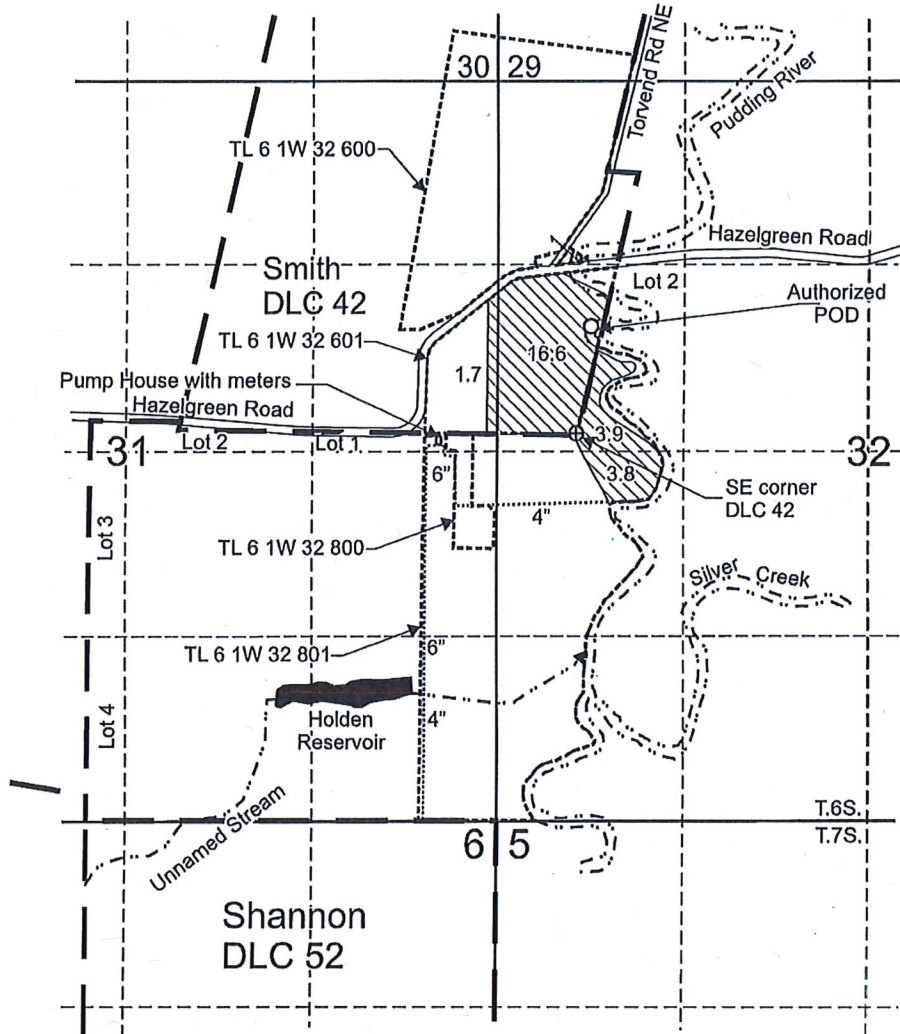


Authorized POD is located 760 feet north and 100 feet east from the SE corner, DLC 42.

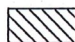 "To" Area (26.0 Acres) to be irrigated under this transfer.

 Tax lot boundary

 Donation Land Claim boundary

 Water main line

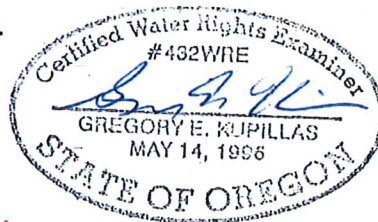

*revised 5/28/19*

EXPIRATION DATE: 6/30/2019

Scale: 1" = 1,320'



This map was prepared for the purpose of identifying the location of a water right only and is not intended to provide legal dimensions or location of property ownership lines.




Pacific Hydro-Geology Inc.

04/2019  
05/2019 Rev.

Transfer Application To" Map  
Certificate 40143

Steven V. and Constance A. Johnson  
T.6S. R.1W. Sec. 31 & 32, W.M.

# T. 6S. R. 1W. W.M.

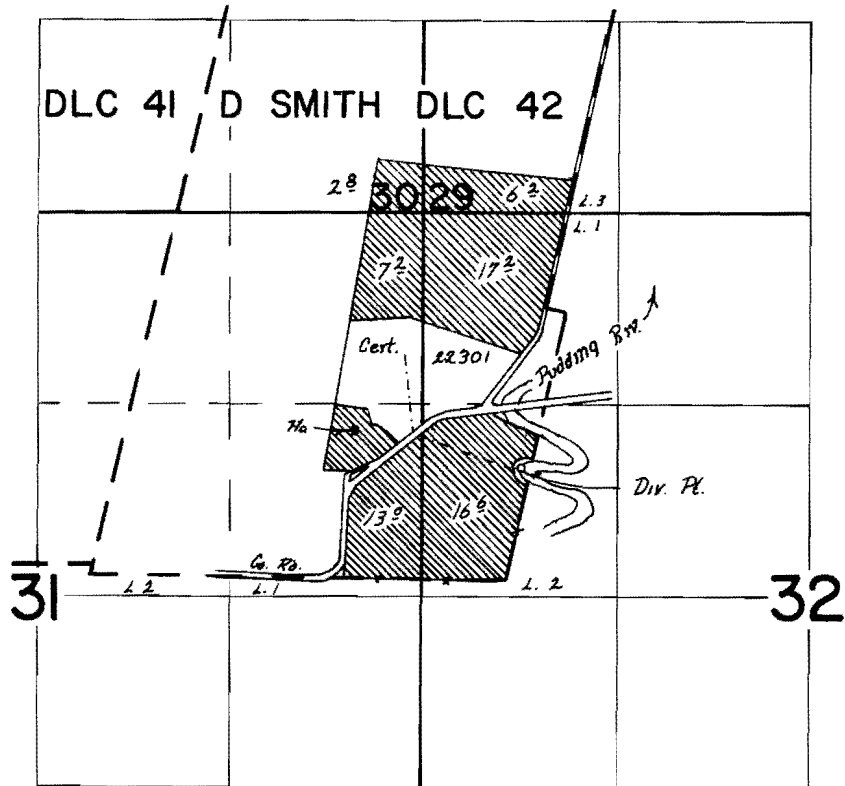

Div. Pt. Loc: 760' N & 100' E From SE Cor D. Smith's DLC 42

## FINAL PROOF SURVEY UNDER

TRANSFER No. Y-31  
Application No. 44897 Permit No. 33568  
IN NAME OF  
GEORGE VACHTER

Surveyed MAY 31 1972, by P. B. Mucken