


T. 3 S. R. 4 W. W. M.

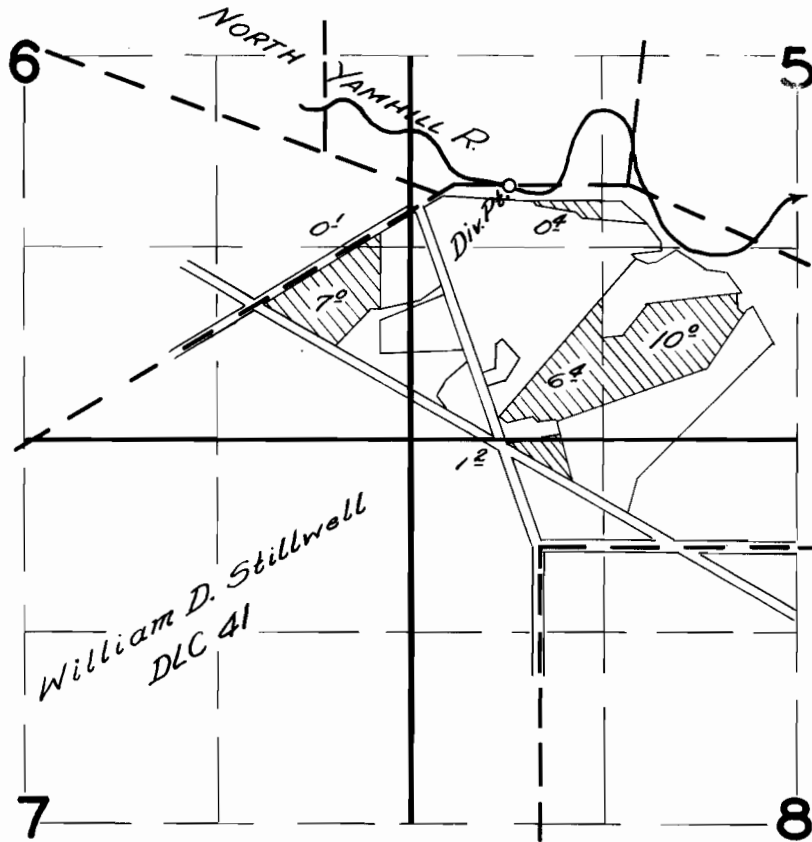


**FINAL PROOF SURVEY**  
UNDER


Application No. *28292* Permit No. *22244*  
IN NAME OF

*Harry H. Williams*


Surveyed *May 8, 1958*, by *M. Bisk*

# Certificate 26134 IR - FROM


T3S, R4W, WM 


-  26134 IR No Change
-  26134 Transfer From

POD 1  
1630' N & 830' E from the  
SW corner of Section 5

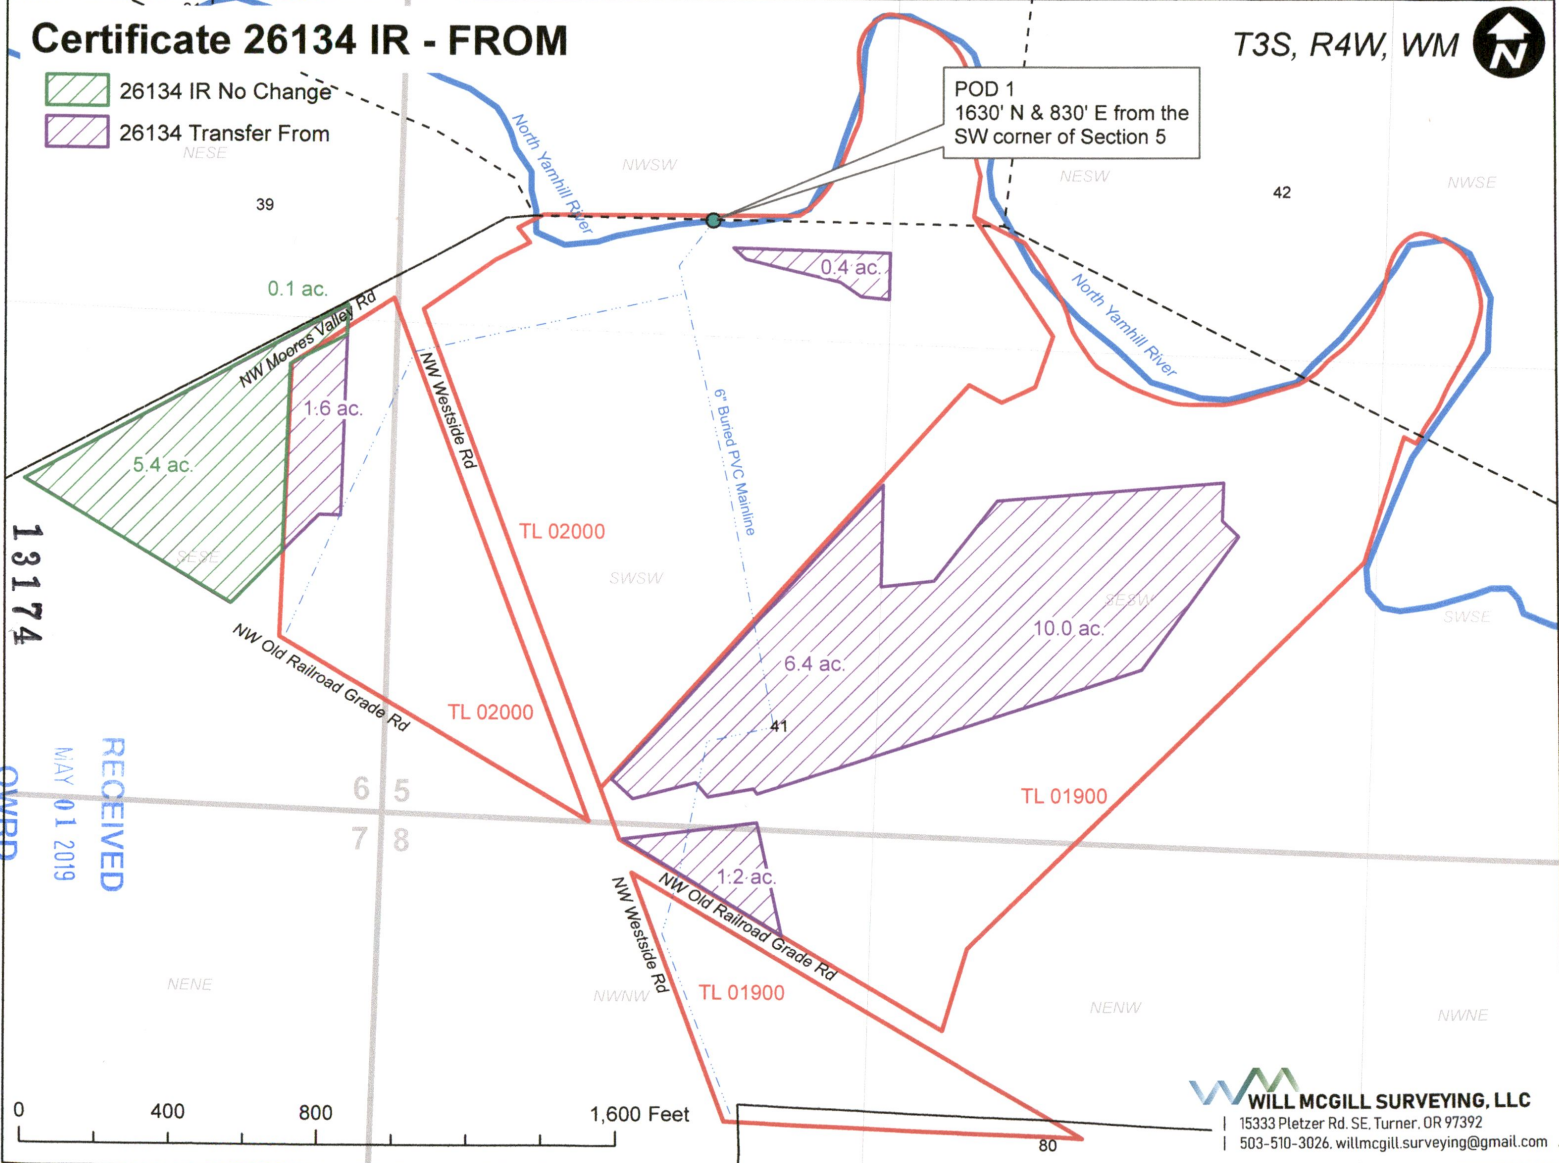

13174  
RECEIVED  
MAY 01 2019  
OWRD

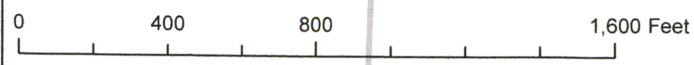

 **WILL MCGILL SURVEYING, LLC**  
15333 Pletzer Rd. SE, Turner, OR 97392  
503-510-3026, willmcgill.surveying@gmail.com