


# T.3S.R.4W.W.M.

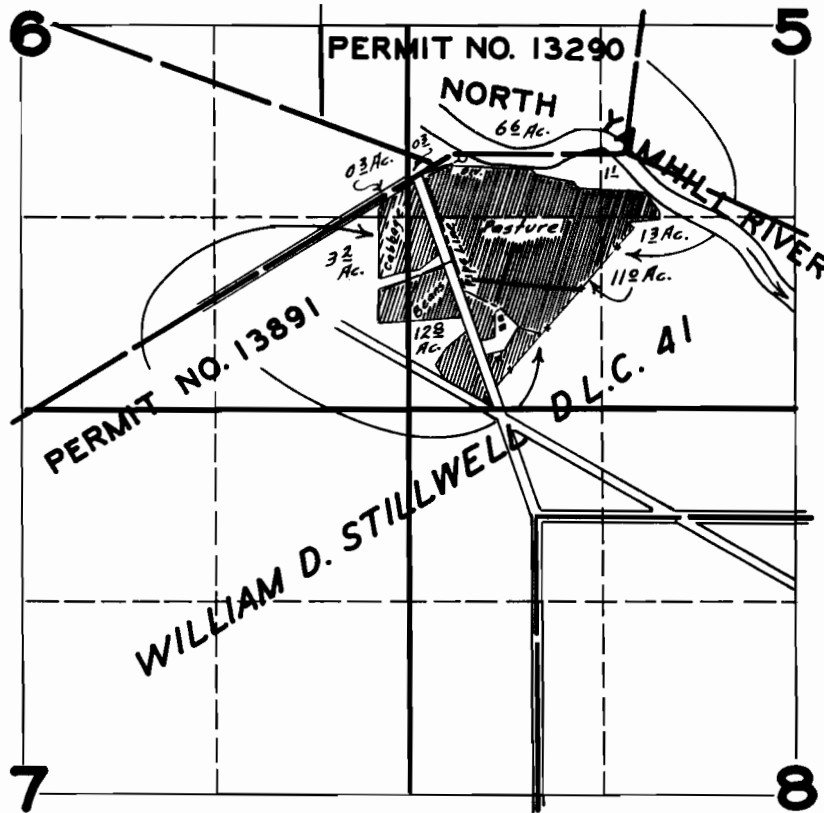

## FINAL PROOF SURVEY

UNDER

Application No. 17594 18230 Permit No. 13290 13891

IN NAME OF

BOB B. WEBB

Surveyed SEP. 6 1946, by [Signature]

# Certificate 59989 IR - FROM


T3S, R4W, WM



 59989 IR Transfer From

POD 2  
1620' N & 630' E from the  
SW corner of Section 5


POD 1  
1630' N & 830' E from the  
SW corner of Section 5

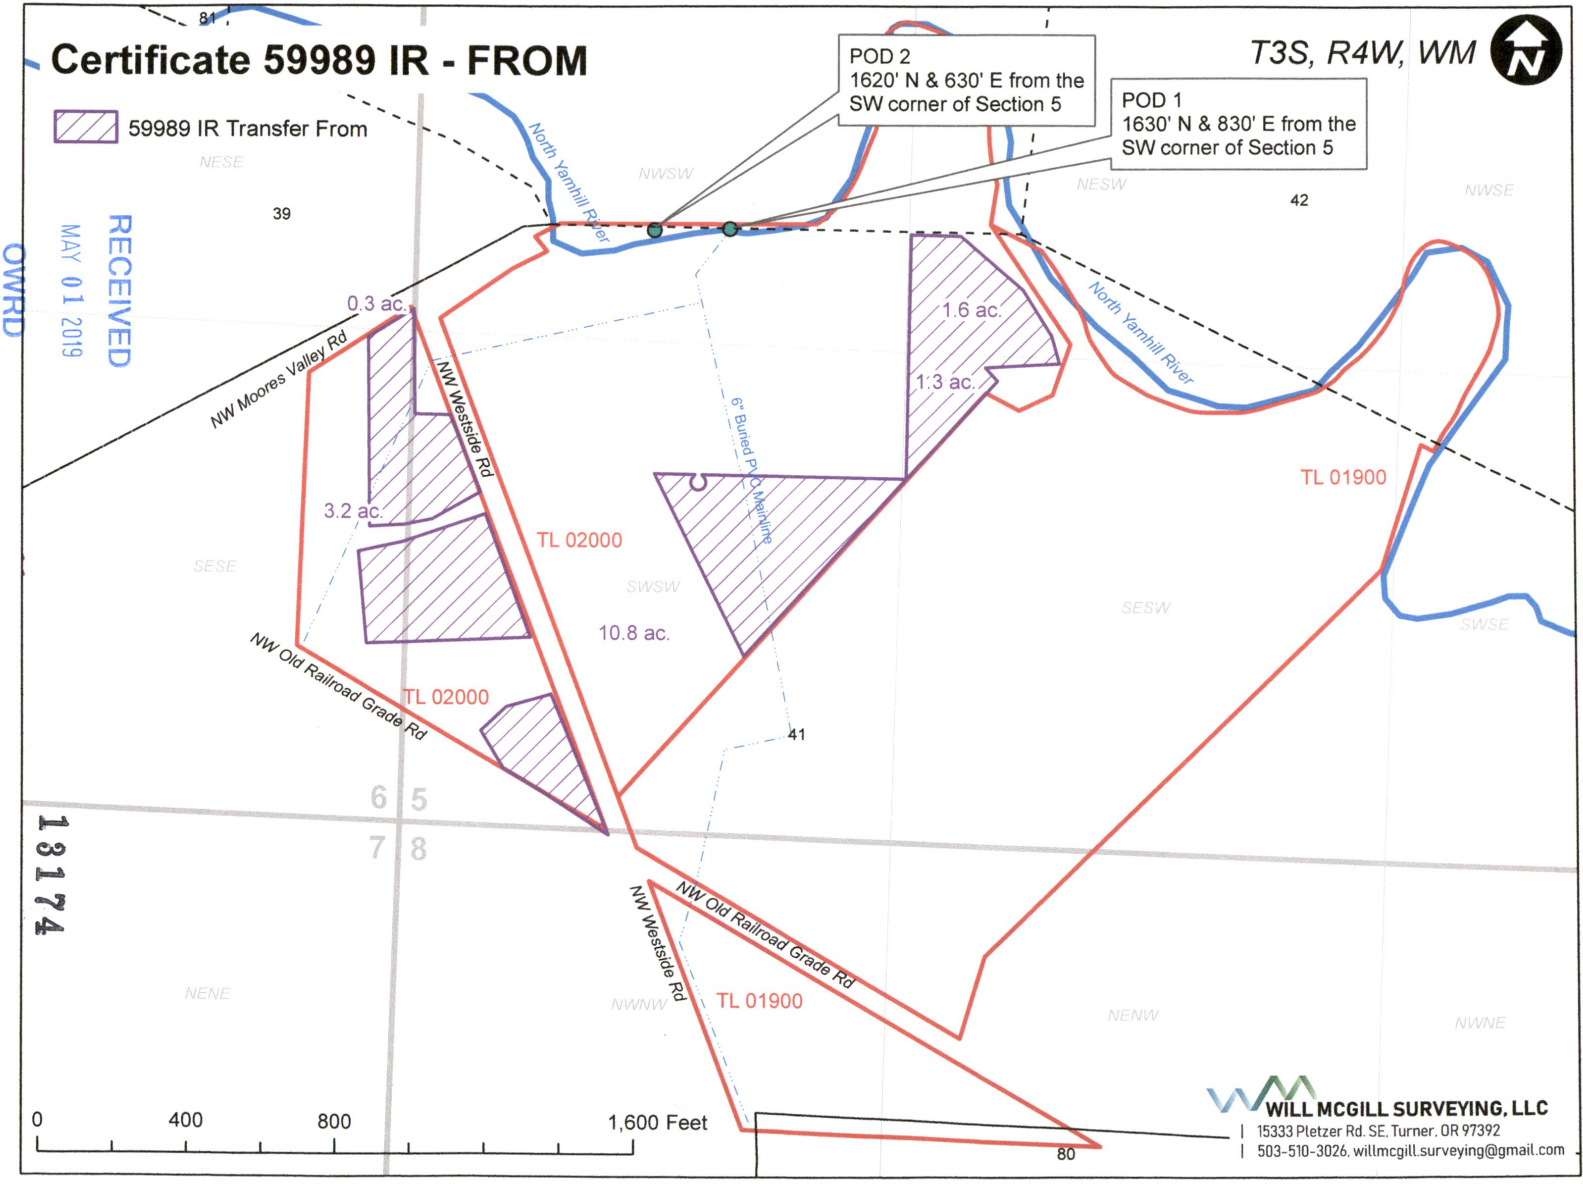

RECEIVED  
MAY 01 2019

13174

OWRD

 **WILL MCGILL SURVEYING, LLC**  
15333 Pletzer Rd. SE, Turner, OR 97392  
503-510-3026, willmcgill.surveying@gmail.com