
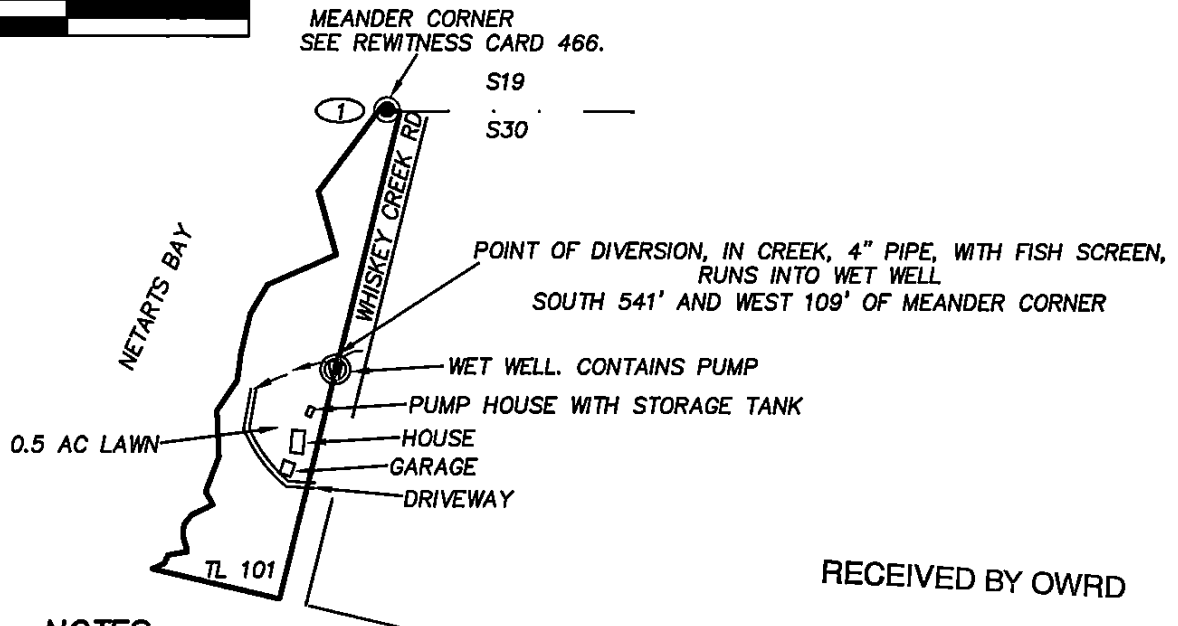
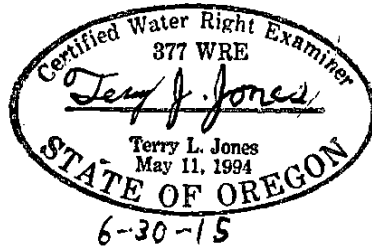


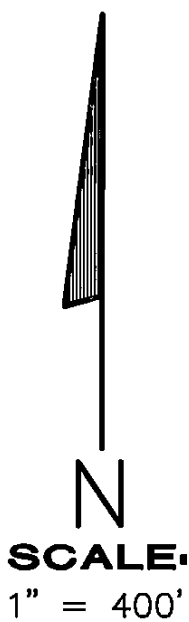

NOTES

THE PURPOSE OF THIS MAP IS TO SHOW THE LOCATION OF
THE POINT OF DIVERSION AND THE PLACE OF USE FOR
WATER RIGHTS APPLICATION NUMBER S-84362, PERMIT
NUMBER S-53722.

THIS MAP DOES NOT CONSTITUTE A BOUNDARY SURVEY

RECEIVED BY OWRD

MAY 04 2015

SALEM, OR

SITE\HATHWAT.DWG
HATHAWAY.CR5

SURVEY BY:
BAYSIDE SURVEYING ©
11765 HWY 101 SOUTH
TILLAMOOK, OR. 97141
(503) 842-5551

WATER RIGHTS MAP FOR:

BEN HATHAWAY

BOOK 372. PAGE 342

TAX LOT 101

NE 1/4 SECTION 30, T2S, R10W, W.M.

TILLAMOOK COUNTY, OREGON

DATE	EQUIPMENT	FIELD	DRAWN	CHECKED	JOB NO.
MARCH 3, 2015	TOPCON ES-103 SPECTRA NOMAD	TLJ/DWE	DWE	TLJ	