


# T.15S., R.4W., W.M.

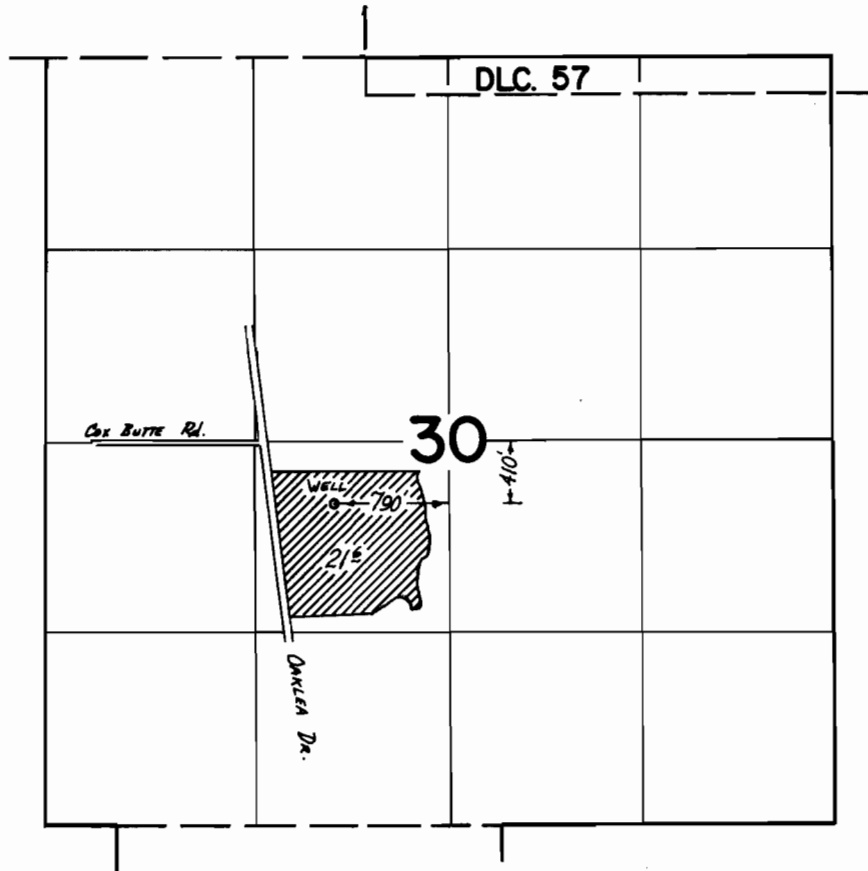

## FINAL PROOF SURVEY UNDER

Application No. G-4766 Permit No. G-4489  
IN NAME OF

CLARRY A. OTTOSEN

Surveyed 25 Sept. 1972, by D. NORBY