


T. 17S, R. 20E, W.M.

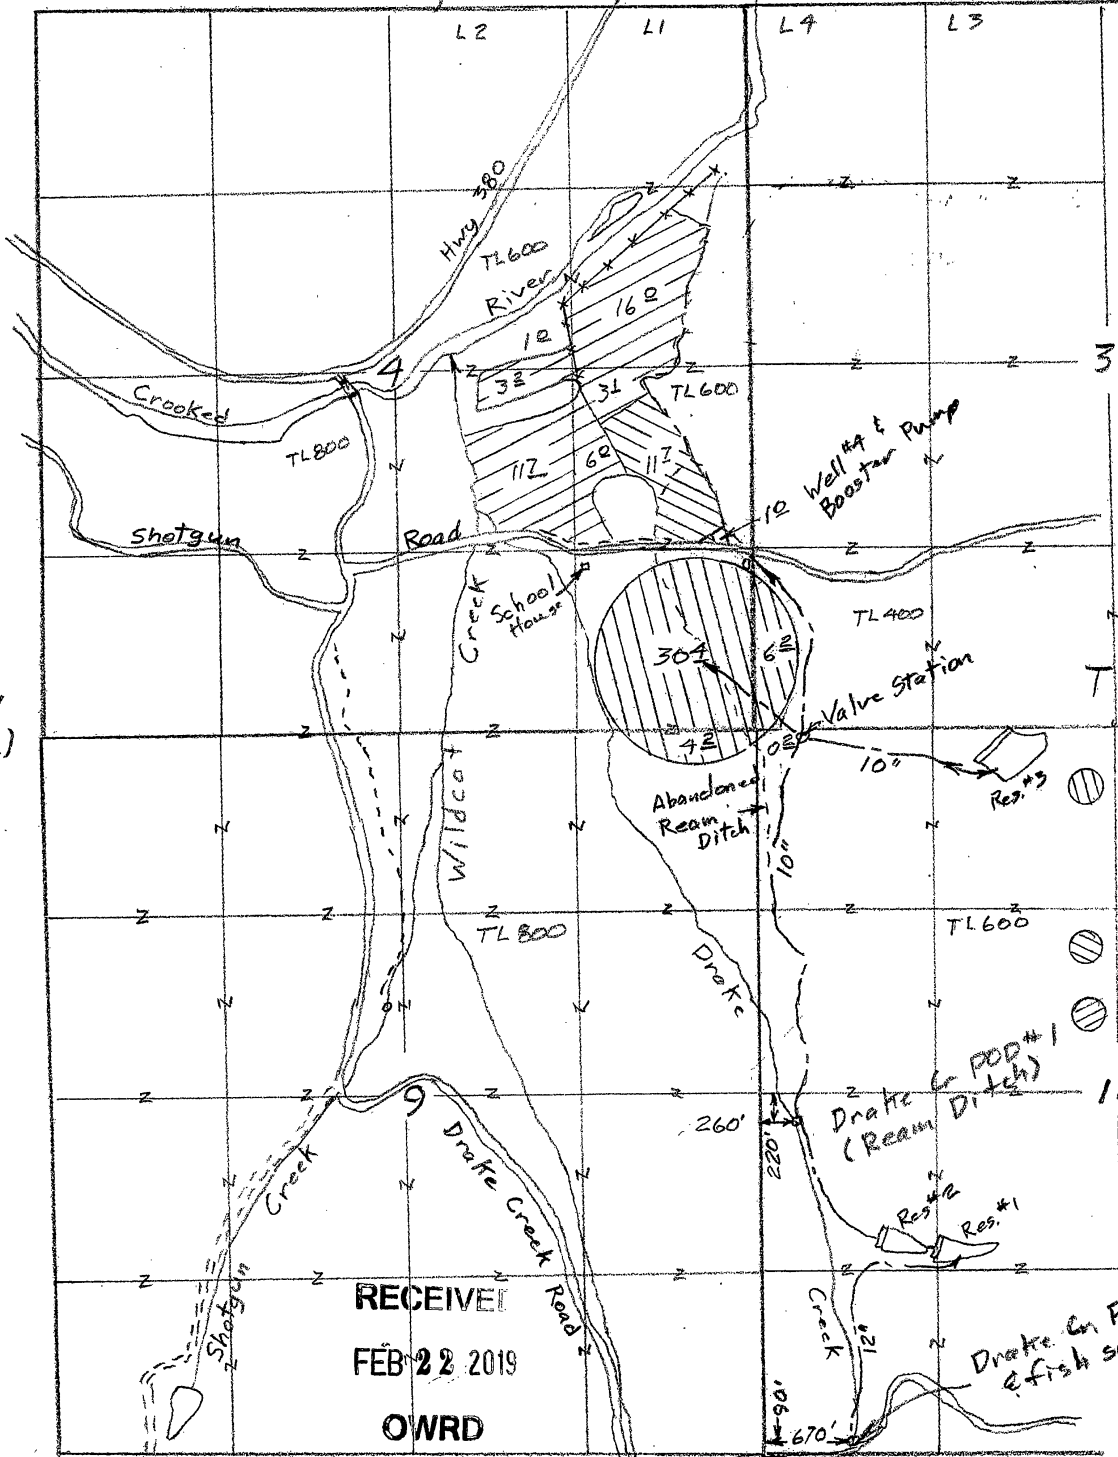

Scale  
1" = 1320'  
(4" = 1 mile)

- T.O
- C-649 Drake Cr. 1888 42°
  - C-81673 1903 11Z
  - C-10844 1917 41° (includes Ream's Res.)

RECEIVED  
FEB 22 2019  
OWRD


Drake Cr. POD #1  
Drake Cr. POD #2  
AG, we  
& fish screen

Claim of Beneficial Use Map  
for  
Shotgun Ranch, LLC

Surveyed March 19, 2018 T-11750

Sheet 2 of 2

This map is for the purpose of locating a water right only and has no intent to provide legal dimensions or the locator of property lines.

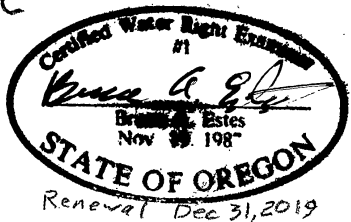

**ESTES SURVEYS, LLC**  
 PO Box 47840 Salem, OR 97306-7519 (503) 585-7599  
 60382 Arnold Rd Bend, OR 97702 (541) 382-7391