



T.17S., R.20E., W.M.

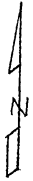

Surveyed March 10, 2018  
 C-81673 (Shotgun Cr.)  
 Scale 1"=1320'  
 (4"=1 mile)  
 To: 10<sup>±</sup> acres 1889  
 Remaining Right  
 10<sup>±</sup> acres 1889

Shotgun  
POD 1 &  
fish screen

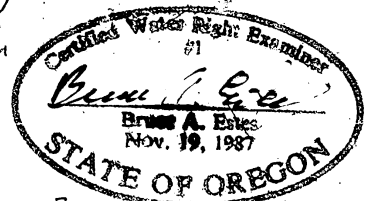


Claim of Beneficial Use Map T-11750  
 for  
 Shotgun Ranch, LLC

This map is for the purpose of  
 locating a water right only  
 and has no intent to provide  
 legal dimensions or the location  
 of property lines.

Sheet 1 of 2  
 Renewal Dec 31, 2019  
**ESTES SURVEYS, LLC**  
 PO Box 17518  
 Salem, OR 97306-7519  
 (503) 565-7503  
 60352 Arnold Rd  
 Bend, OR 97702  
 (541) 382-7391

T. 17S., R. 20E., W.M.

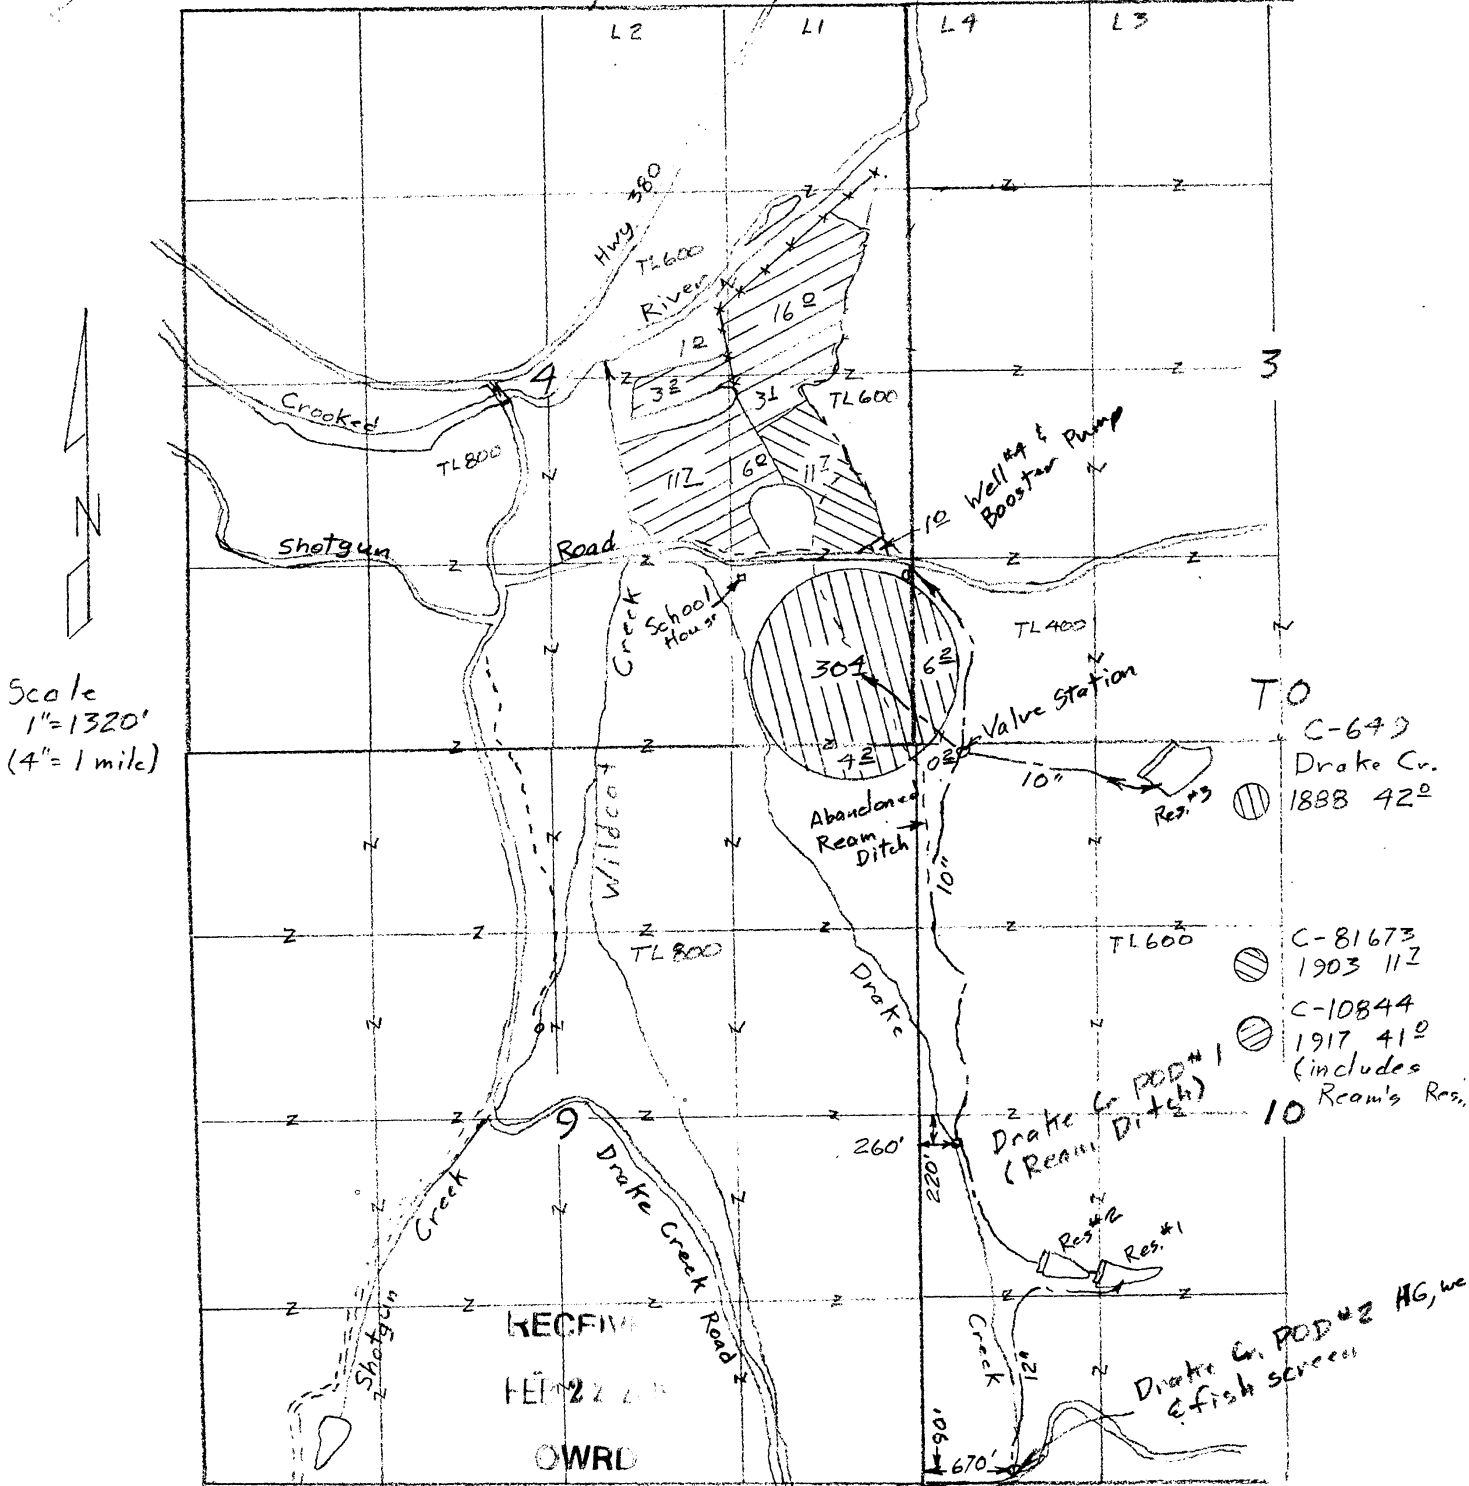


Scale  
1" = 1320'  
(4" = 1 mile)

Claim of Beneficial Use Map  
for  
Shotgun Ranch, LLC

Surveyed March 10, 2018 T-11750

Sheet 2 of 2

This map is for the purpose of locating a water right only and has no intent to provide legal dimensions or the location of property lines.

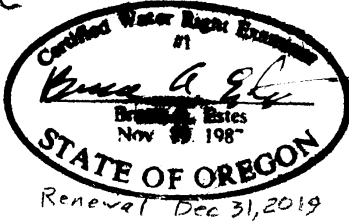

**ESTES SURVEYS, LLC**  
 PO Box 47810  
 Salem, OR 97308-7518  
 (503) 585-7585  
 60382 Arnold Rd  
 Bend, OR 97702  
 (541) 382-7391