


COBU Map 893

G:\1000\1028\101\Cod\Water\W1028101\_F1\_FrTo COBU 10.41 01/13/2015 SS

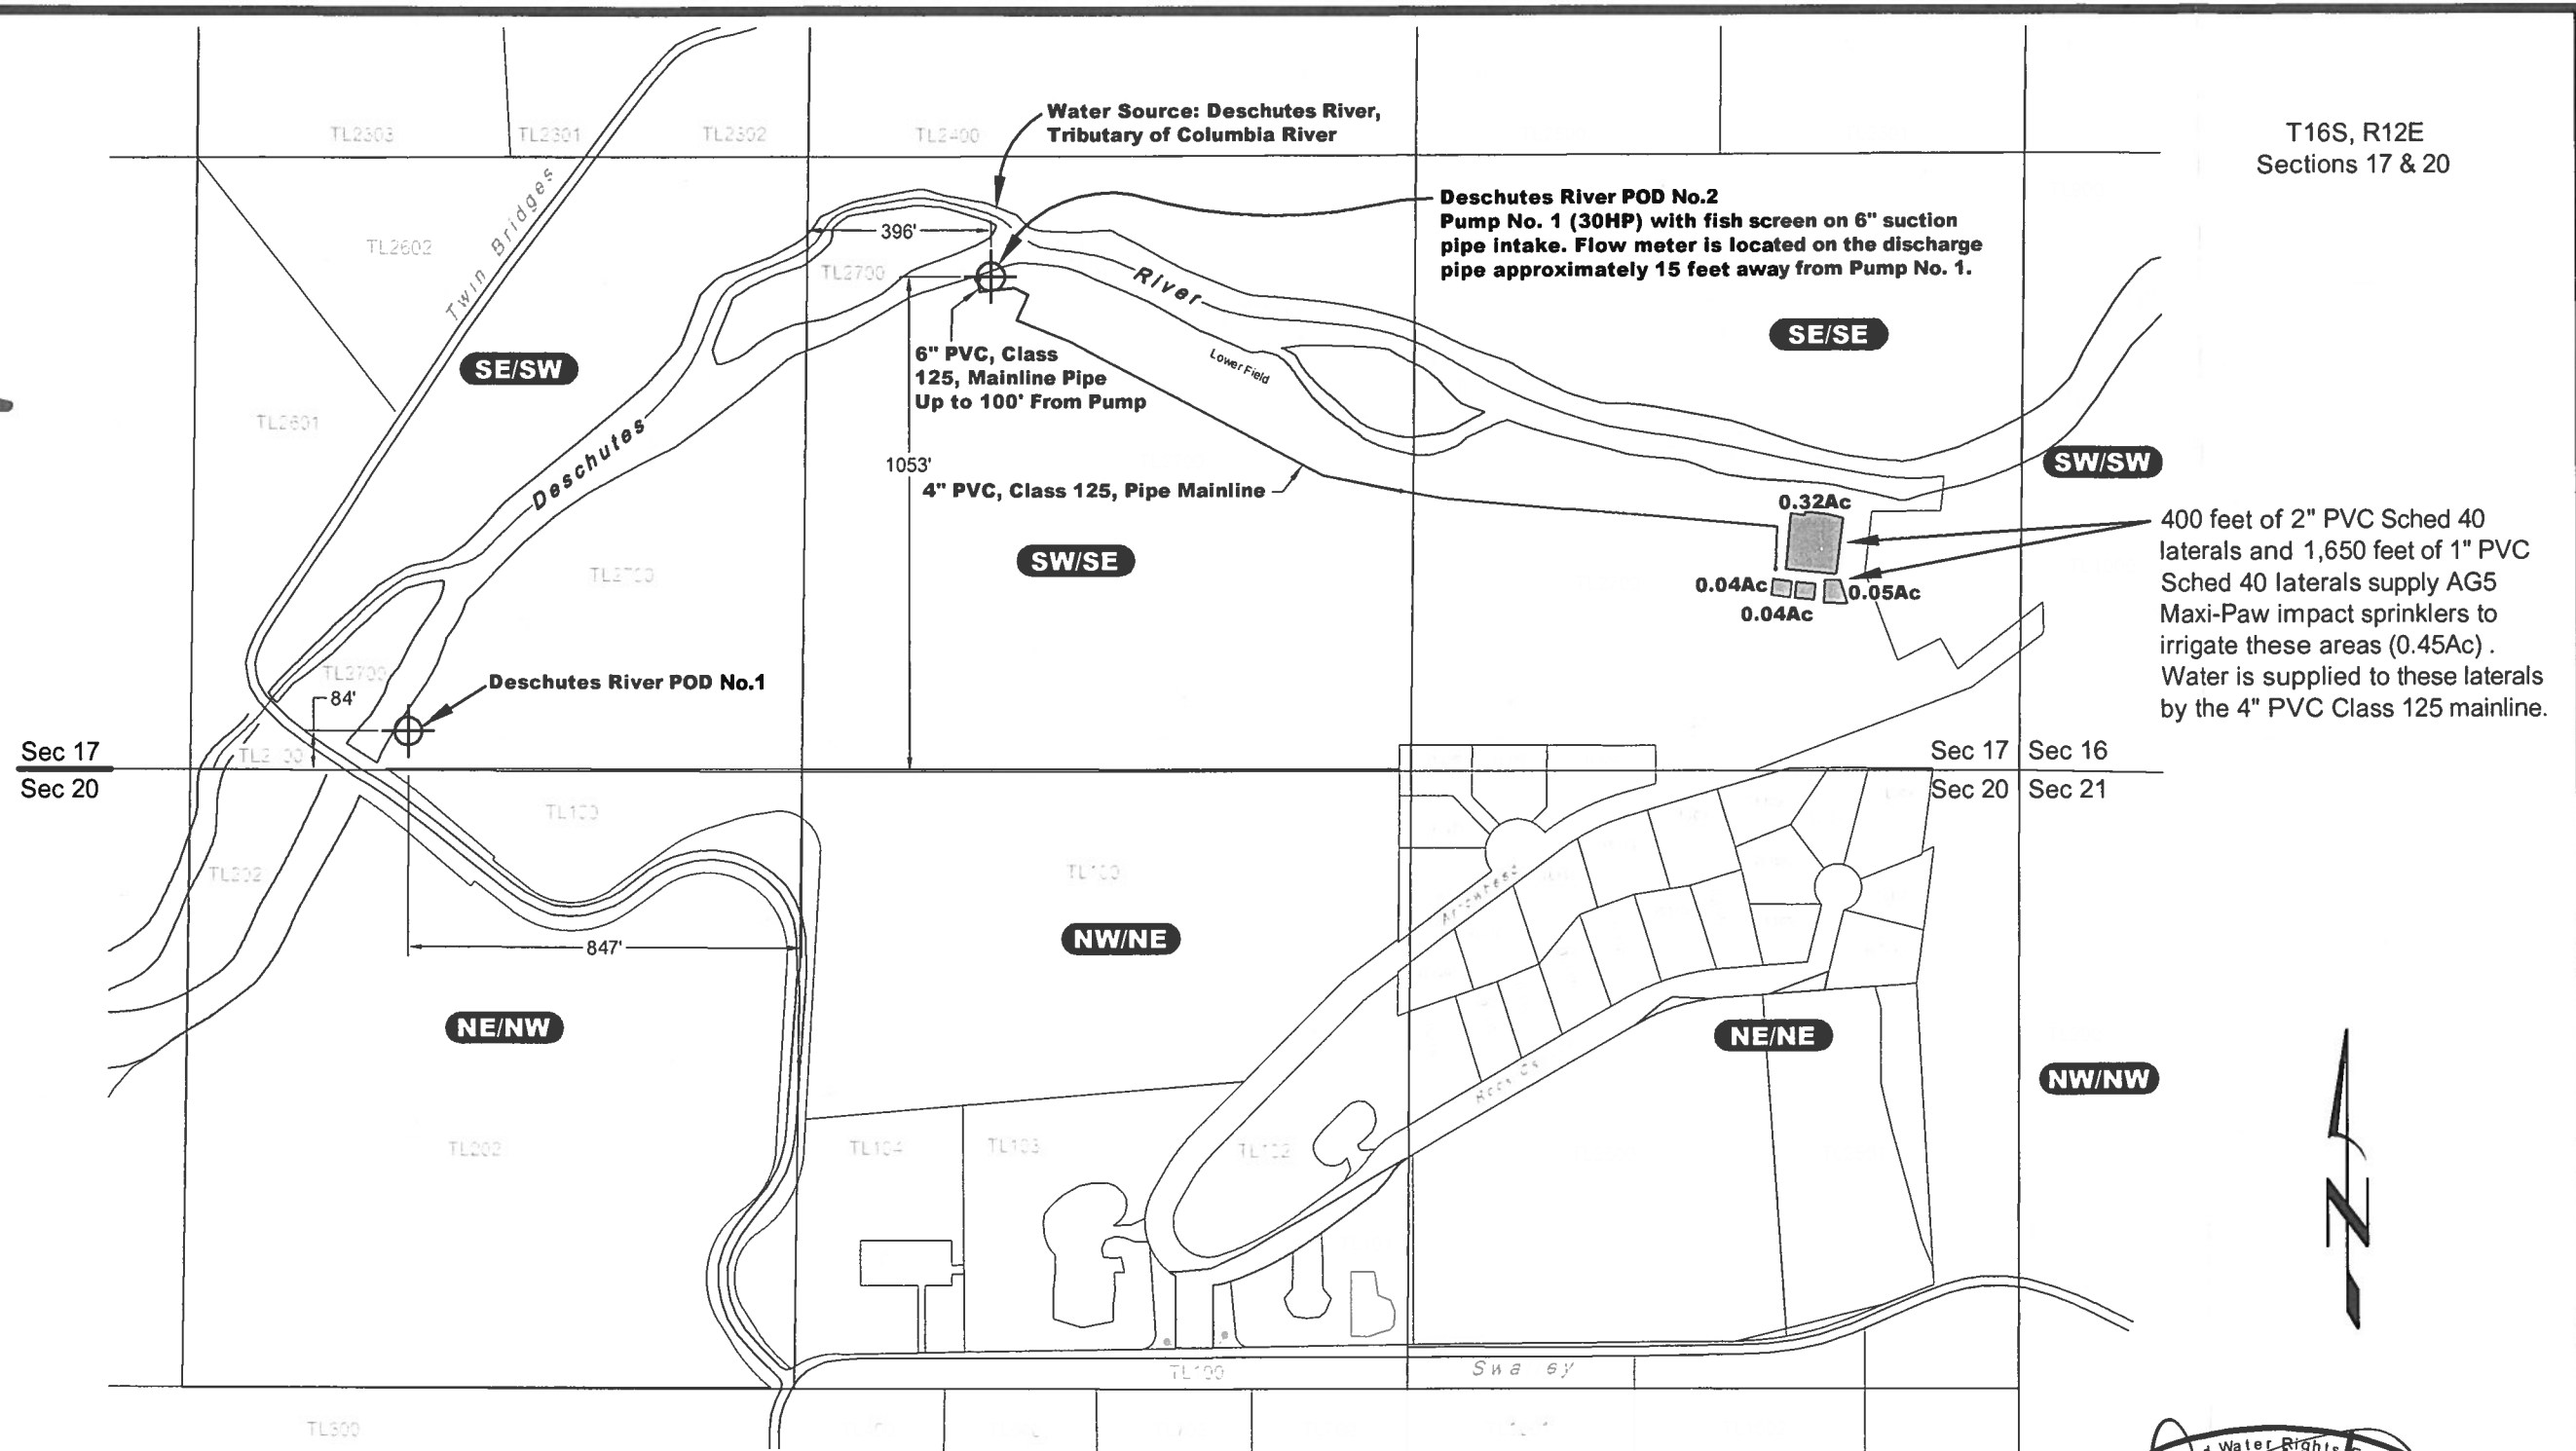

T16S, R12E  
Sections 17 & 20

Sec 17  
Sec 20


Sec 17 Sec 16  
Sec 20 Sec 21

**EXPLANATION**

■ "TO" Deschutes River  
Diversions CW-43 (C-83243)

**NOTES**

This map was prepared for the purpose of identifying the location of water rights only and is not intended to provide legal dimensions or locations of property ownership lines.

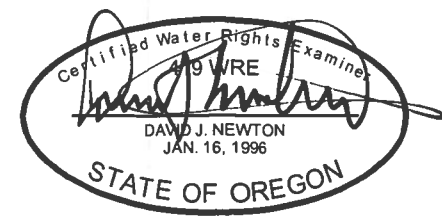

SCALE: 1" = 400'

Claim of Beneficial Use Map  
 Deschutes River Ranch CW-43  
 (Certificate C-83243)  
 Deschutes River Ranch, Oregon



**NEWTON**  
**CONSULTANTS INC.**  
 Earth, Water and Rock Specialists  
 Ph: 541 504-9960  
 Fax: 541 504-9961

DESIGNED BY: D. Newton

DRAWN BY: S. Schenck

DATE: OCT 2015

PROJECT NO: 1028-101

FIGURE 1

COBU MAP 893