


T.22S.R.5W.W.M.

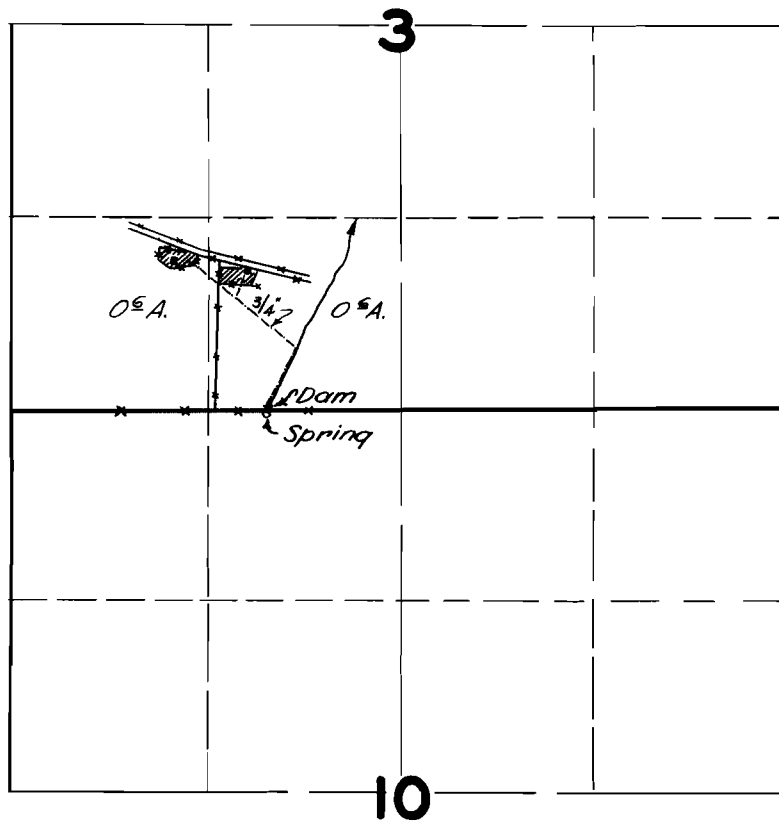

FINAL PROOF SURVEY

UNDER

Application No. 22268 Permit No. 17563...

IN NAME OF

.....W.C. & RUTH E. PERKINS.....

Surveyed MAY 15, 1950., by H.L. COFFMAN