

RECEIVED

FEB 27 2019

# T.4S. R.1W. Sec. 27 & 28, W.M.


QWRD

SENE

Hovenden  
DLC 76

Section 28  
Section 27

SWSW

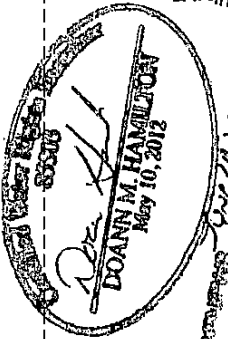

Unnamed  
Intermittent Creek

Mill Creek

TL 04 1W 27 300

SE corner  
DLC 76

NESE

Lot 1

0.1

4.4

5.8

Buried 3"

1:0

1:7

Lot 5

NWSW

POD Certificate  
20069

0.4

3:3

9:0

Buried 3"

Portable 3"

TL 04 1W 27 400

5th St.

Well 1  
(MARI 50236)  
and meter

Well 1 (MARI 50236) is located 700 feet south and 665 feet west from the SE corner, DLC 76.

POD Certificate 20069 is located NESE Lot 1, T.4S., R.1W., Section 28.



Area (13.4 Acres) primary irrigation under Application G-14274, Permit G-13473.



Area (15.0 Acres) supplemental irrigation under Application G-14274, Permit G-13473, primarily irrigated by Certificate 20069




Combined Area (28.4 Acres) agricultural use under Application G-14274, Permit G-13473.

----- Tax lot boundary

———— Donation Land Claim boundary

..... Water main line

Scale: 1" = 400'

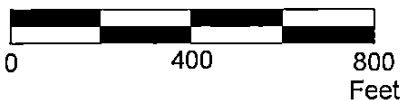

This map was prepared for the purpose of identifying the location of a water right only and is not intended to provide legal dimensions or location of property ownership lines.

### Claim of Beneficial Use Map Application G-14274, Permit G-13473

Dong Hyon and Yong Im Baik  
T.4S. R.1W. Sec. 27 & 28, W.M.

Pacific Hydro-Geology Inc.

12/2018

Loen-BaikCOBU.cdr