


T. 2 N. R. 42 E. W.M.

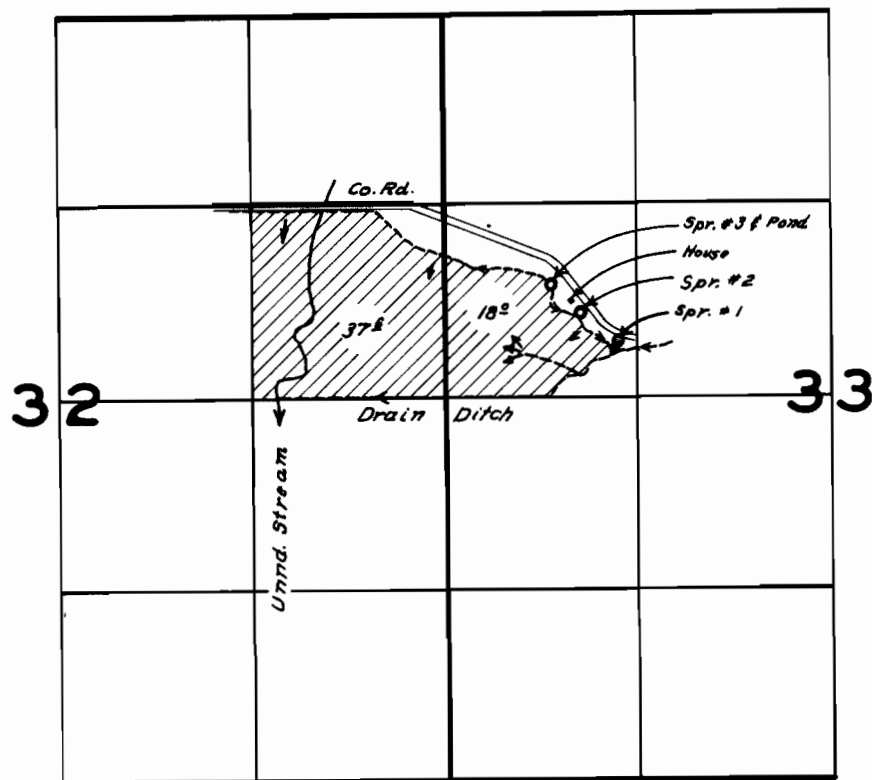

**FINAL PROOF SURVEY**  
UNDER

Application No. 27237 Permit No. 21430  
IN NAME OF

*Flying A Quarter Circle Ranches, Inc.*


Surveyed *Aug. 12, 1959*, by *R. H. Jackson*

RECEIVED

OCT 12 2018

OWRD

T. 2 N., R. 42 E., W.M.

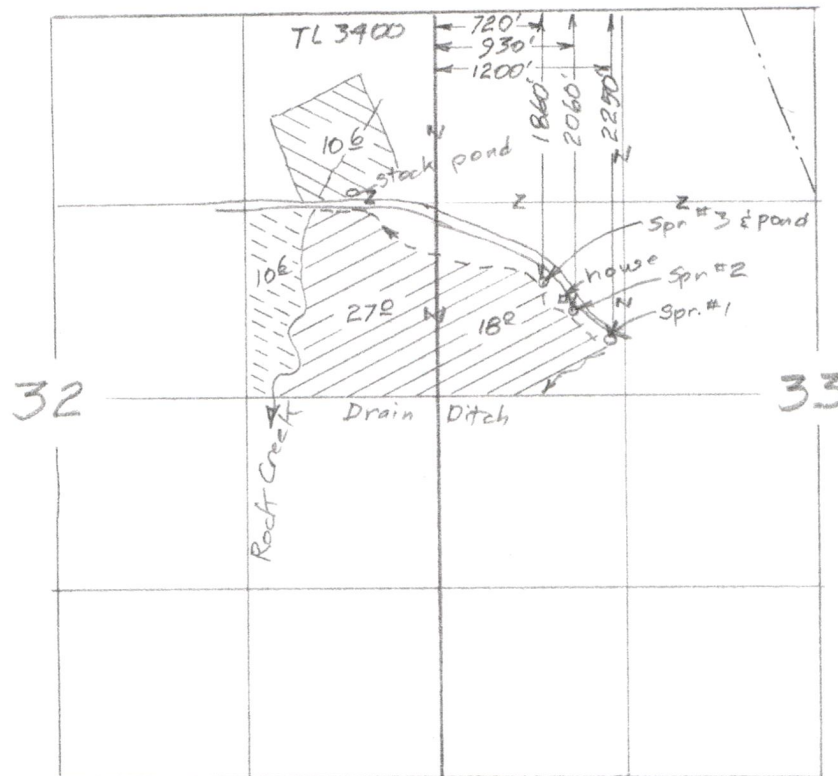

Scale 1"=1320'  
(4"=1 mile)

C-26916

⊗ From 106 acres

⊗ To 106 acres


⊗ Remain in place 452 acres

Transfer Application Map  
for  
Ron & Pat Fox

RECEIVED

SEP 28 2018

OWRD

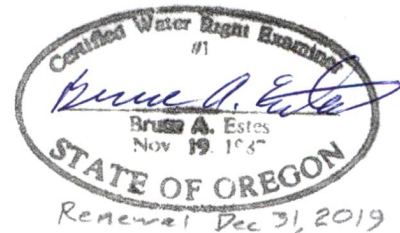

This map is for the purpose of  
locating a water right only  
and has no intent to provide  
legal dimensions or the location  
of property lines.

ESTES SURVEYS, LLC

PO Box 47519  
Salem, OR 97305-7519  
(503) 585-7593

60382 Arnold Rd  
Bend, OR 97702  
(541) 382-7381