


TOWNSHIP 17 SOUTH, RANGE 4 WEST, W.M.

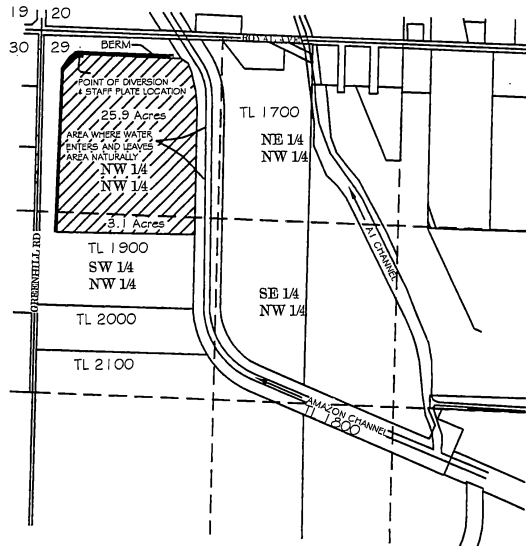

APPLICATION R-84310

PERMIT R-12887

 AREA OF BENEFICIAL USE


POINT OF DIVERSION  
178 FEET SOUTH &  
282 FEET EAST OF  
NW COR. SEC. 29

NOTE:  
THE PREPARATION OF THE MAP WAS  
FOR THE PURPOSE OF IDENTIFYING THE  
LOCATION OF THE WATER RIGHT ONLY.  
IT IS NOT INTENDED TO PROVIDE  
LOCATION NOR DIMENSION OF PROPERTY  
OWNERSHIP LINES.

FINAL PROOF SURVEY

FOR  
CITY OF EUGENE  
1820 ROOSEVELT BLVD  
EUGENE, OR 97402  
541-682-4800

BY  
H. TIMOTHY FASSBENDER, PLS, CWRE  
99 EAST BROADWAY SUITE 400  
EUGENE, OR. 97401  
541-682-2704  
NOVEMBER 16, 2015

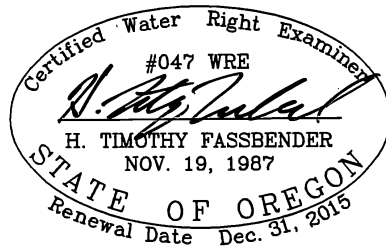

RECEIVED

NOV 16 2015

EUGENE, OR