


# T.6S. R.1W. Sec. 13, 14, 23, & 24

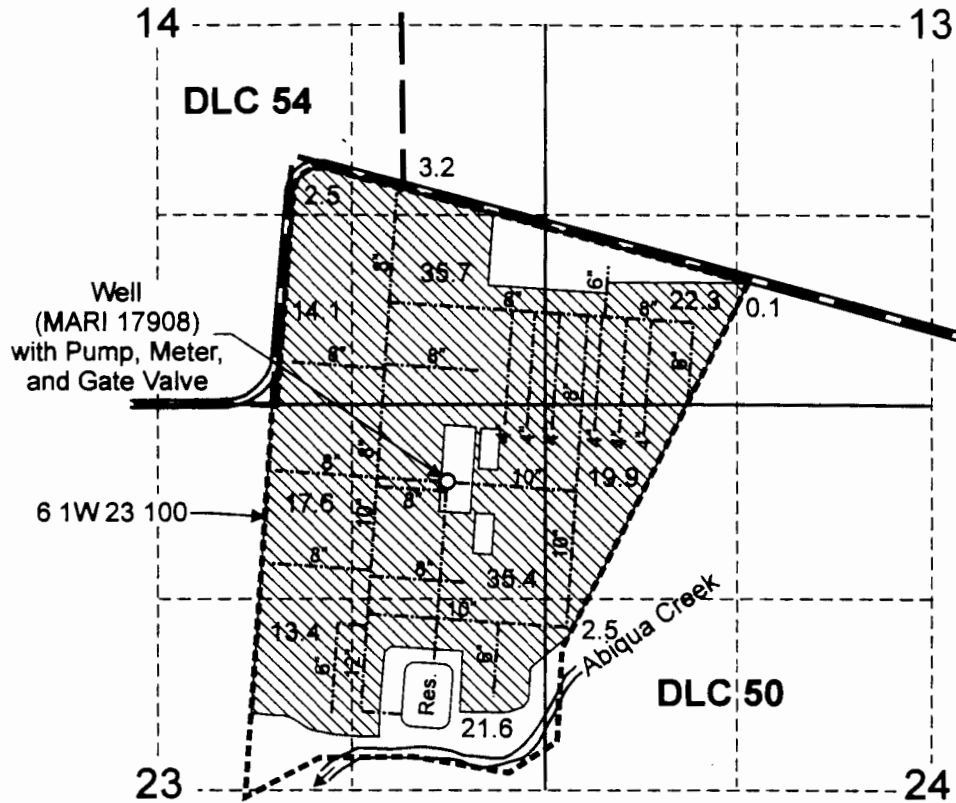


Well (MARI 17908) is located 2,250 feet south and 1,060 feet east from the NW corner of DLC 50.

 Area (188.3 Acres) covered by nursery operations under Application G-14930, Permit G-13783.

 Tax lot boundary

 Irrigation Mainline

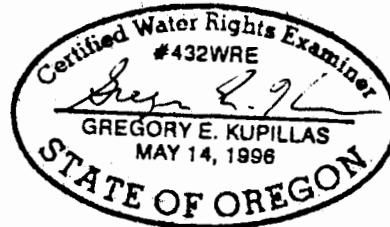


EXPIRATION DATE: 6/30/09

RECEIVED

OCT 01 2008

WATER RESOURCES DEPT  
SALEM OREGON

Scale: 1" = 1,320'

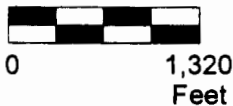

This map was prepared for the purpose of identifying the location of a water right only and is not intended to provide legal dimensions or location of property ownership lines.



Claim of Beneficial Use Map  
Application G-14930, Permit G-13783

Paul Kraemer  
Tax Lot 6 1W 23 100

Pacific Hydro-Geology Inc.

9/2008

KraemersNurseryG14930.cdr

1994

May Rd NE

Downs Rd NE

RECEIVED  
APR 15 2019  
OWRD

© 2018 Google


Imagery Date: 7/26/2018

45°02'25.74" N 122°45'30.93" W




13167

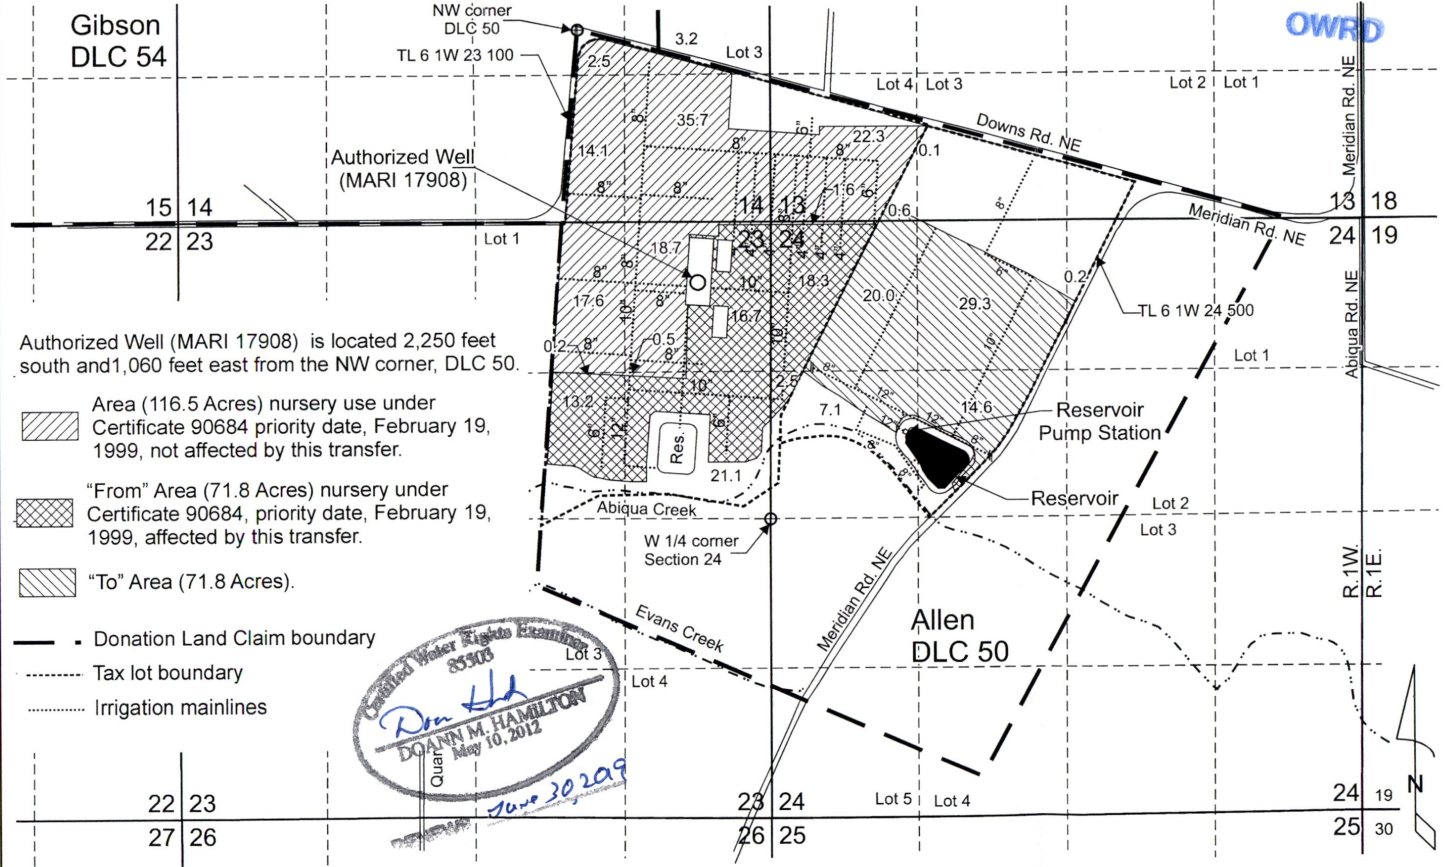


RECEIVED  
APR 15 2019  
OWRD


# T.6S. R.1W. Sec. 13, 14, 23, & 24, W.M.




Authorized Well (MARI 17908) is located 2,250 feet south and 1,060 feet east from the NW corner, DLC 50.

-  Area (116.5 Acres) nursery use under Certificate 90684 priority date, February 19, 1999, not affected by this transfer.
-  "From" Area (71.8 Acres) nursery under Certificate 90684, priority date, February 19, 1999, affected by this transfer.
-  "To" Area (71.8 Acres).

-  Donation Land Claim boundary
-  Tax lot boundary
-  Irrigation mainlines

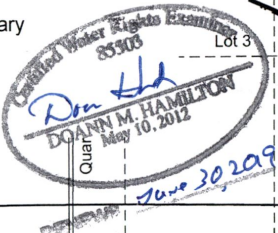
  
 Doann M. HAMILTON  
 June 30, 2019

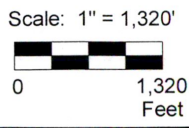

This map was prepared for the purpose of identifying the location of a water right only and is not intended to provide legal dimensions or location of property ownership lines.

Pacific Hydro-Geology Inc.

03/2019

## Transfer Application Map Certificate 90684

Paul Kraemer  
T.6S. R.1W. Sec. 13, 14, 23, & 24, W.M.

13167

Kraemer/AbbeyTran.cdr