


CLAIM OF BENEFICIAL USE MAP
FOR GLASS FAMILY TRUST
LOCATED IN THE SE1/4 OF THE SW1/4 OF SECTION 8
TOWNSHIP 23 SOUTH, RANGE 12 WEST, W.M.,
COOS COUNTY, OREGON

APPLICATION #S-85774
PERMIT #54062

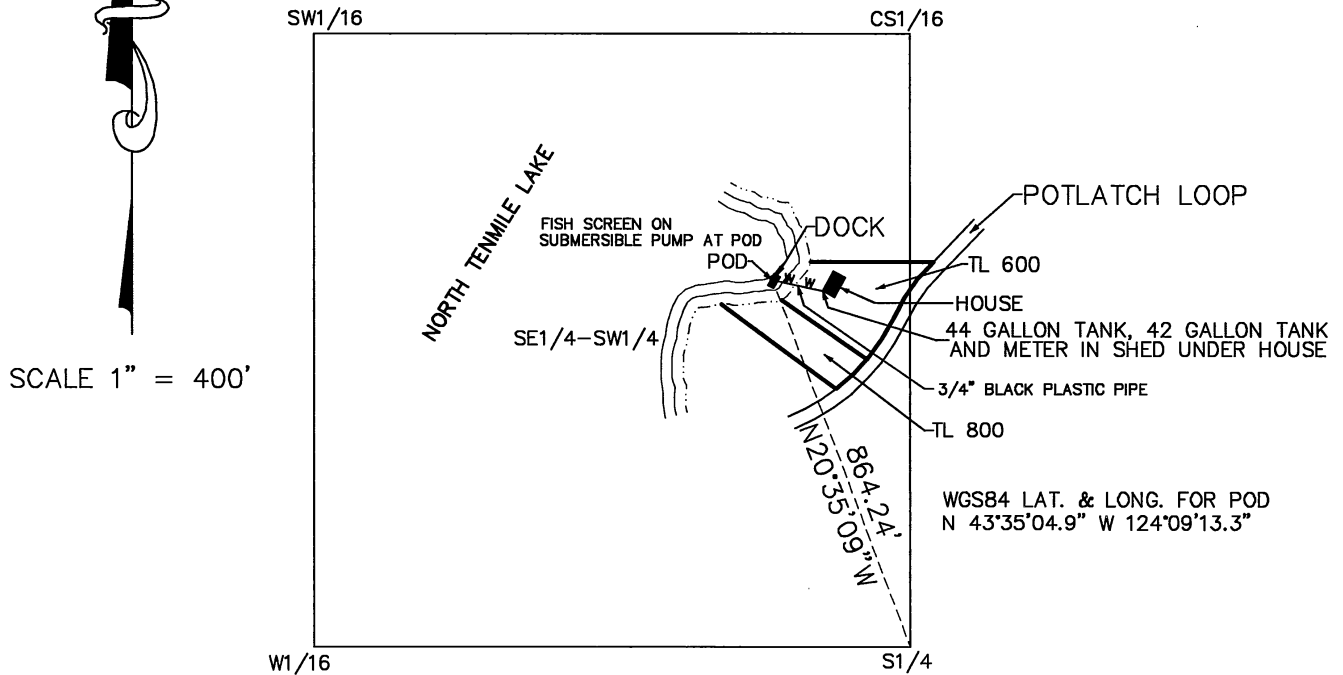


LEGEND:

POD POINT OF DIVERSION

TL TAX LOT

—W— WATER PIPE LINE

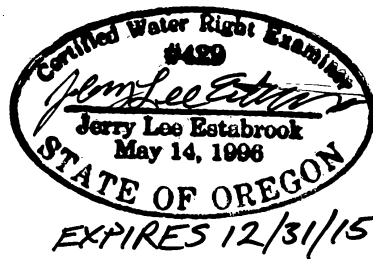

RECEIVED BY OWRD

DEC 21 2015

SALEM, OR

RECEIVED BY OWRD

NOV 30 2015

SALEM, OR

EXAMINERS DISCLAIMER STATEMENT:
THE PREPARATION OF THIS MAP WAS FOR THE PURPOSE OF
IDENTIFYING THE LOCATION OF WATER RIGHT ONLY AND HAS
NO INTENT TO PROVIDE DIMENSIONS OR LOCATION OF
PROPERTY OWNERSHIP LINES.