


T. 31 S., R. 4 W., W.M.

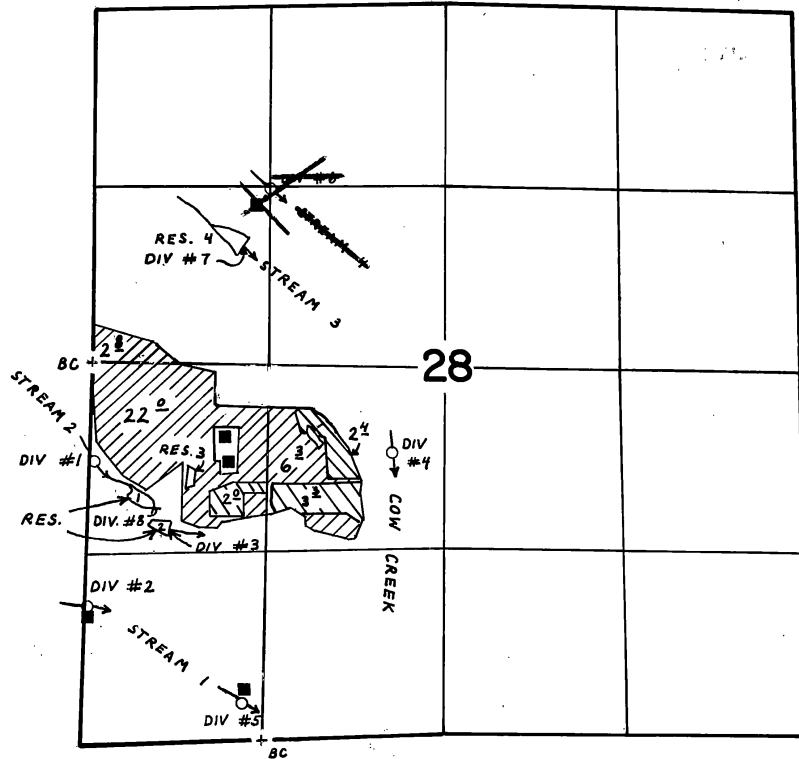

SCALE:
4" = 1 mile

DIV. PT. LOCATION:

- #1 720'S and 10'W
- #2 1790'S 110'W
- #3 1250'S 500'E
- #4 770'S 2160'E
- #5 2550'S 970'E
- ~~#6 1200'N 1370'E~~
- #7 750'N 1150'E
- #8 1060'S 450'E
- ~~#9 210'S 710'E~~



PORTIONS OF CERT. 9609, 20184
NEW IRRIGATION

ALL FROM W. 1/4 COR.
of SEC. 28.

FINAL PROOF SURVEY
UNDER

R-58176 R 7800
Application No. 58177..... Permit No. 43944.....
IN NAME OF

.....LEONARD.....TERRY.....

Surveyed FEB. 28, 1984, by *S. E. Cochran*
MAR. 1, 1984
JUNE 9, 1990 by BS James