


T. 31 S., R. 4 W., W.M.

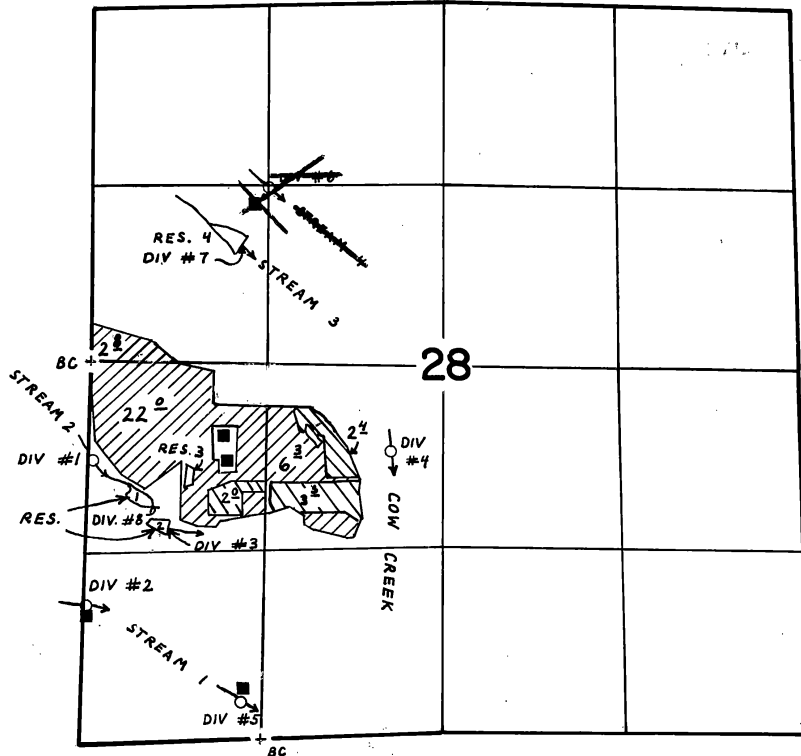

SCALE:
4" = 1 mile

DIV. PT. LOCATION:

- #1 720' S and 10' W
- #2 1790' S 110' W
- #3 1250' S 500' E
- #4 770' S 2160' E
- #5 2550' S 970' E
- ~~#6 1200' N 1370' E~~
- #7 750' N 1150' E
- #8 1060' S 450' E
- ~~#9 210' S 710' E~~



PORTIONS OF CERT. 9609, 20184

NEW IRRIGATION

ALL FROM W. 1/4 COR.
of SEC. 28.

FINAL PROOF SURVEY
UNDER

R-58176 R 7800

Application No. 58177..... Permit No. 43944.....

IN NAME OF

LEONARD TERRY

Surveyed FEB. 28, 1984, by *J. E. Cashman*

MAR. 1, 1984

JUNE 9, 1990 by BS James

3/21/2019 DC

PTS WITH FIELD FORM LEC

6/10/85