


FINAL PROOF SURVEY
CLAIM OF BENEFICIAL USE
PUEBLO SLOUGH WELLS 1-8

Harney County, Oregon

For

Bureau of Land Management

OCTOBER 17, 2018

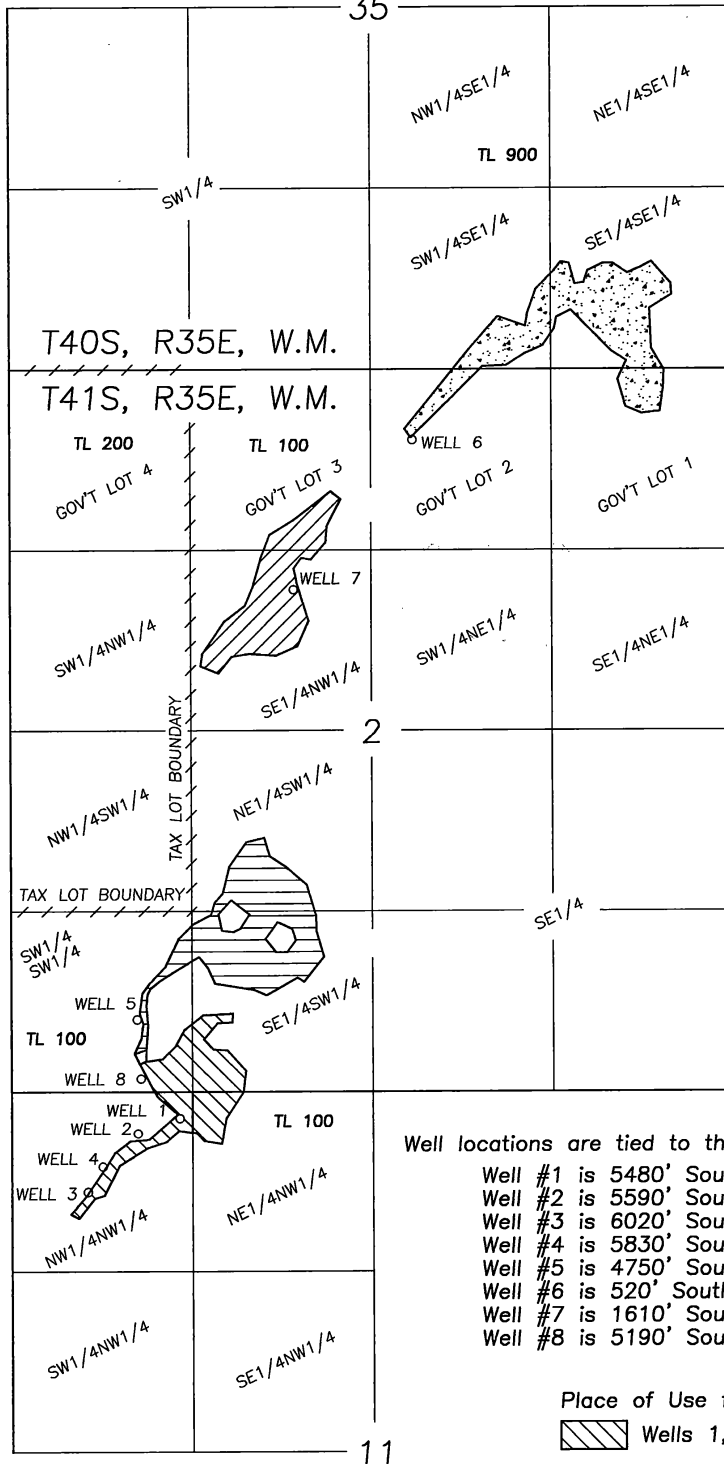

SCALE 1"=1320'

LEGEND

Application No. G-11113

Permit No. G-10559

Priority 1/9/1986

--- Tax Lot Boundary

A portion of Tax Lot
41-35 TL100 AND 40-35 TL900

NOTE: Tax Lot 100 is owned by the BLM
and is more that 13,300 acres.
Therefore only a portion of the tax
lot boundary can be shown.
Tax Lot 900 is owned by the BLM
and is more that 440 acres.

Well locations are tied to the NW corner of Section 2

- Well #1 is 5480' South and 1230' East
- Well #2 is 5590' South and 920' East
- Well #3 is 6020' South and 550' East
- Well #4 is 5830' South and 660' East
- Well #5 is 4750' South and 920' East
- Well #6 is 520' South and 2940' East
- Well #7 is 1610' South and 2070' East
- Well #8 is 5190' South and 940' East

Place of Use for each well

-  Wells 1,2,3,4,8
-  Well 5
-  Well 7
-  Well 6

NOTE: The preparation of this map
was for the purpose of identifying
the location of the proposed water
right and has no intent to provide
dimensions or location of property
ownership lines.

RECEIVED

APR 18 2019

OWRD

