


T13S R30E W.M.

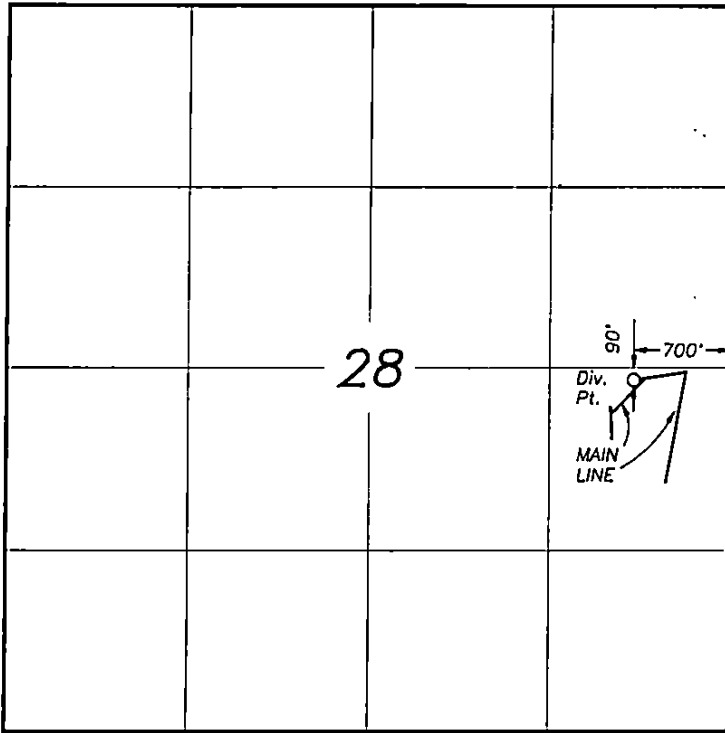

**RECEIVED**

SEP 01 1995  
WATER RESOURCES DEPT  
SALEM, OREGON



SCALE 1" = 1320'

# FINAL PROOF SURVEY

UNDER  
TRANSFER NO. T-6480  
SPECIAL ORDER VOL. 45, PAGE 307

IN NAME OF  
JAMES T. CLARK

SURVEYED July 26, 1995 BY R. D. Bogett

NOTE: The preparation of this map was for the purpose of identifying the location of the proposed diversion point and has no intent to provide dimensions or location of property ownership lines.

